


2/15/2017
2:03:13 PM
R:\Roadway\Proj\670209_rdy_tsh.dgn
Jon.Bell

TIP PROJECT: 17BP.7.R.99

CONTRACT:

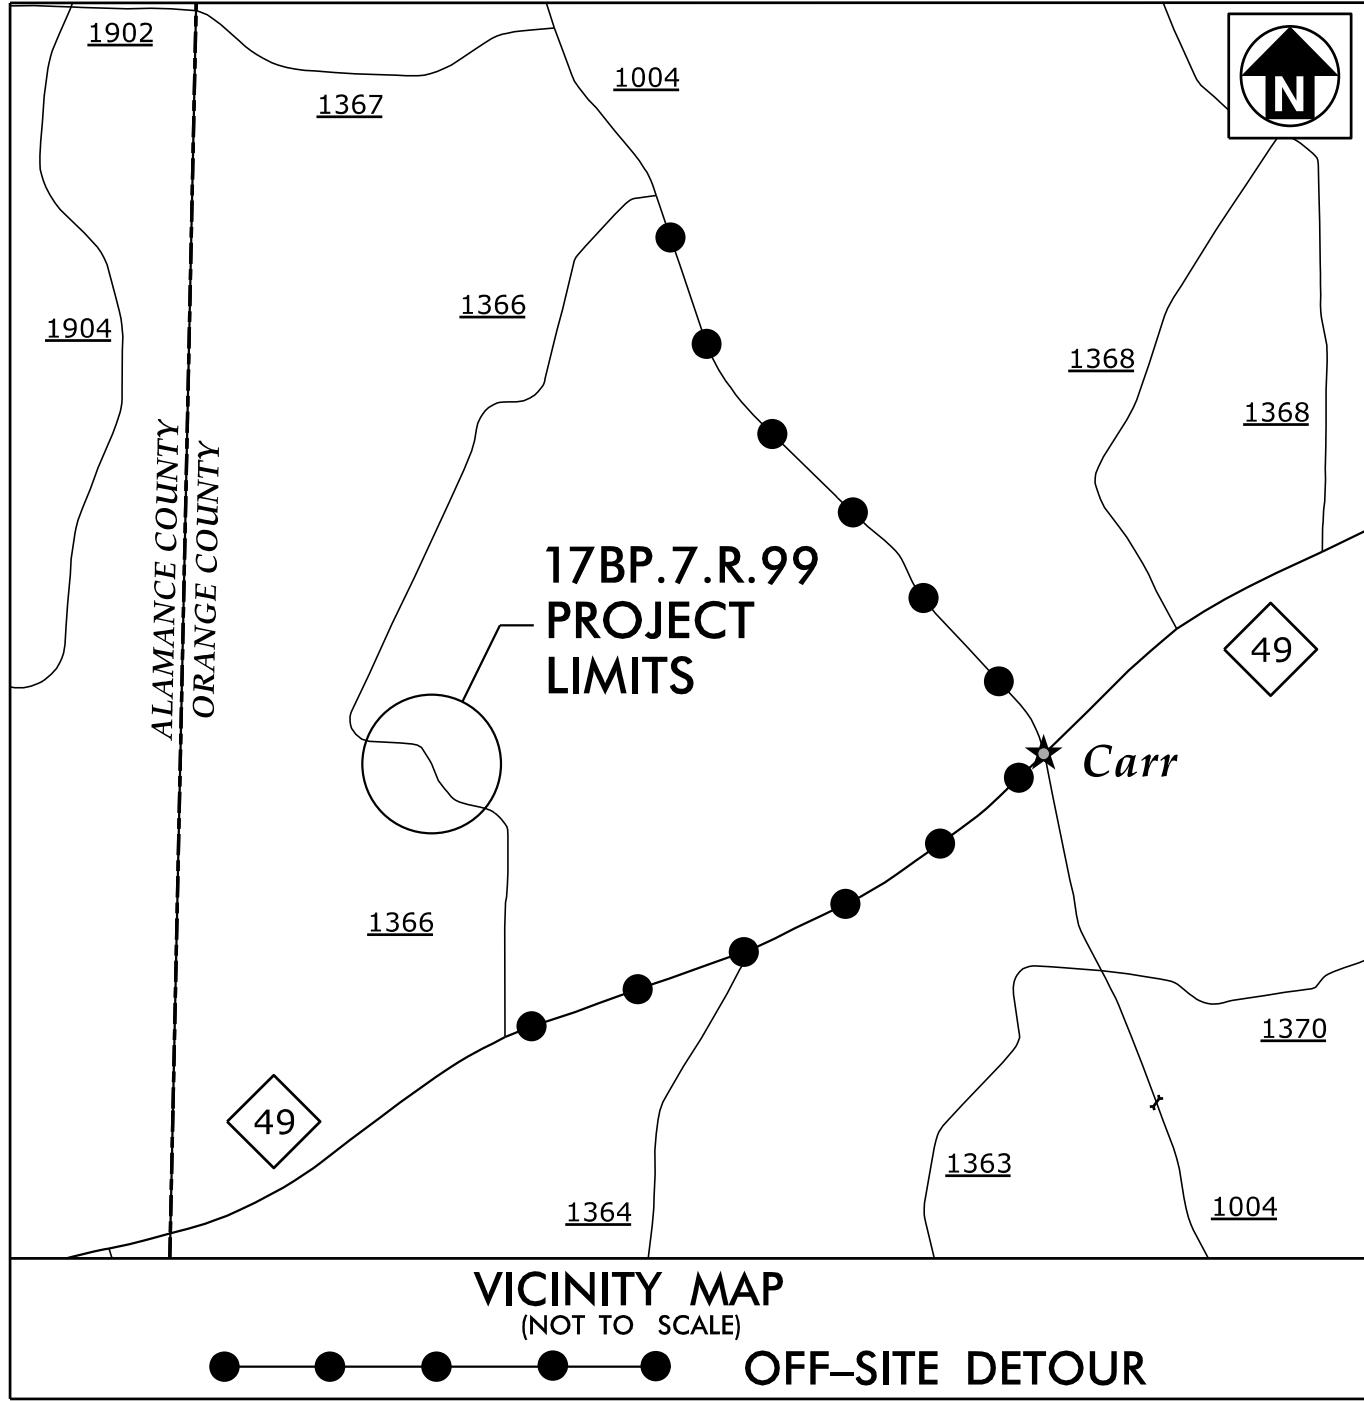


STATE OF NORTH CAROLINA
DIVISION OF HIGHWAYS
ORANGE COUNTY

LOCATION: BRIDGE NO. 209 OVER FRANK CREEK ON SR 1366 (ATKINS ROAD)


TYPE OF WORK: GRADING, PAYING, DRAINAGE AND CULVERT

STATE	STATE PROJECT REFERENCE NO.	SHEET NO.	TOTAL SHEETS
N.C.	17BP.7.R.99	1	
STATE PROJECT NO.	F.A. PROJ. NO.	DESCRIPTION	

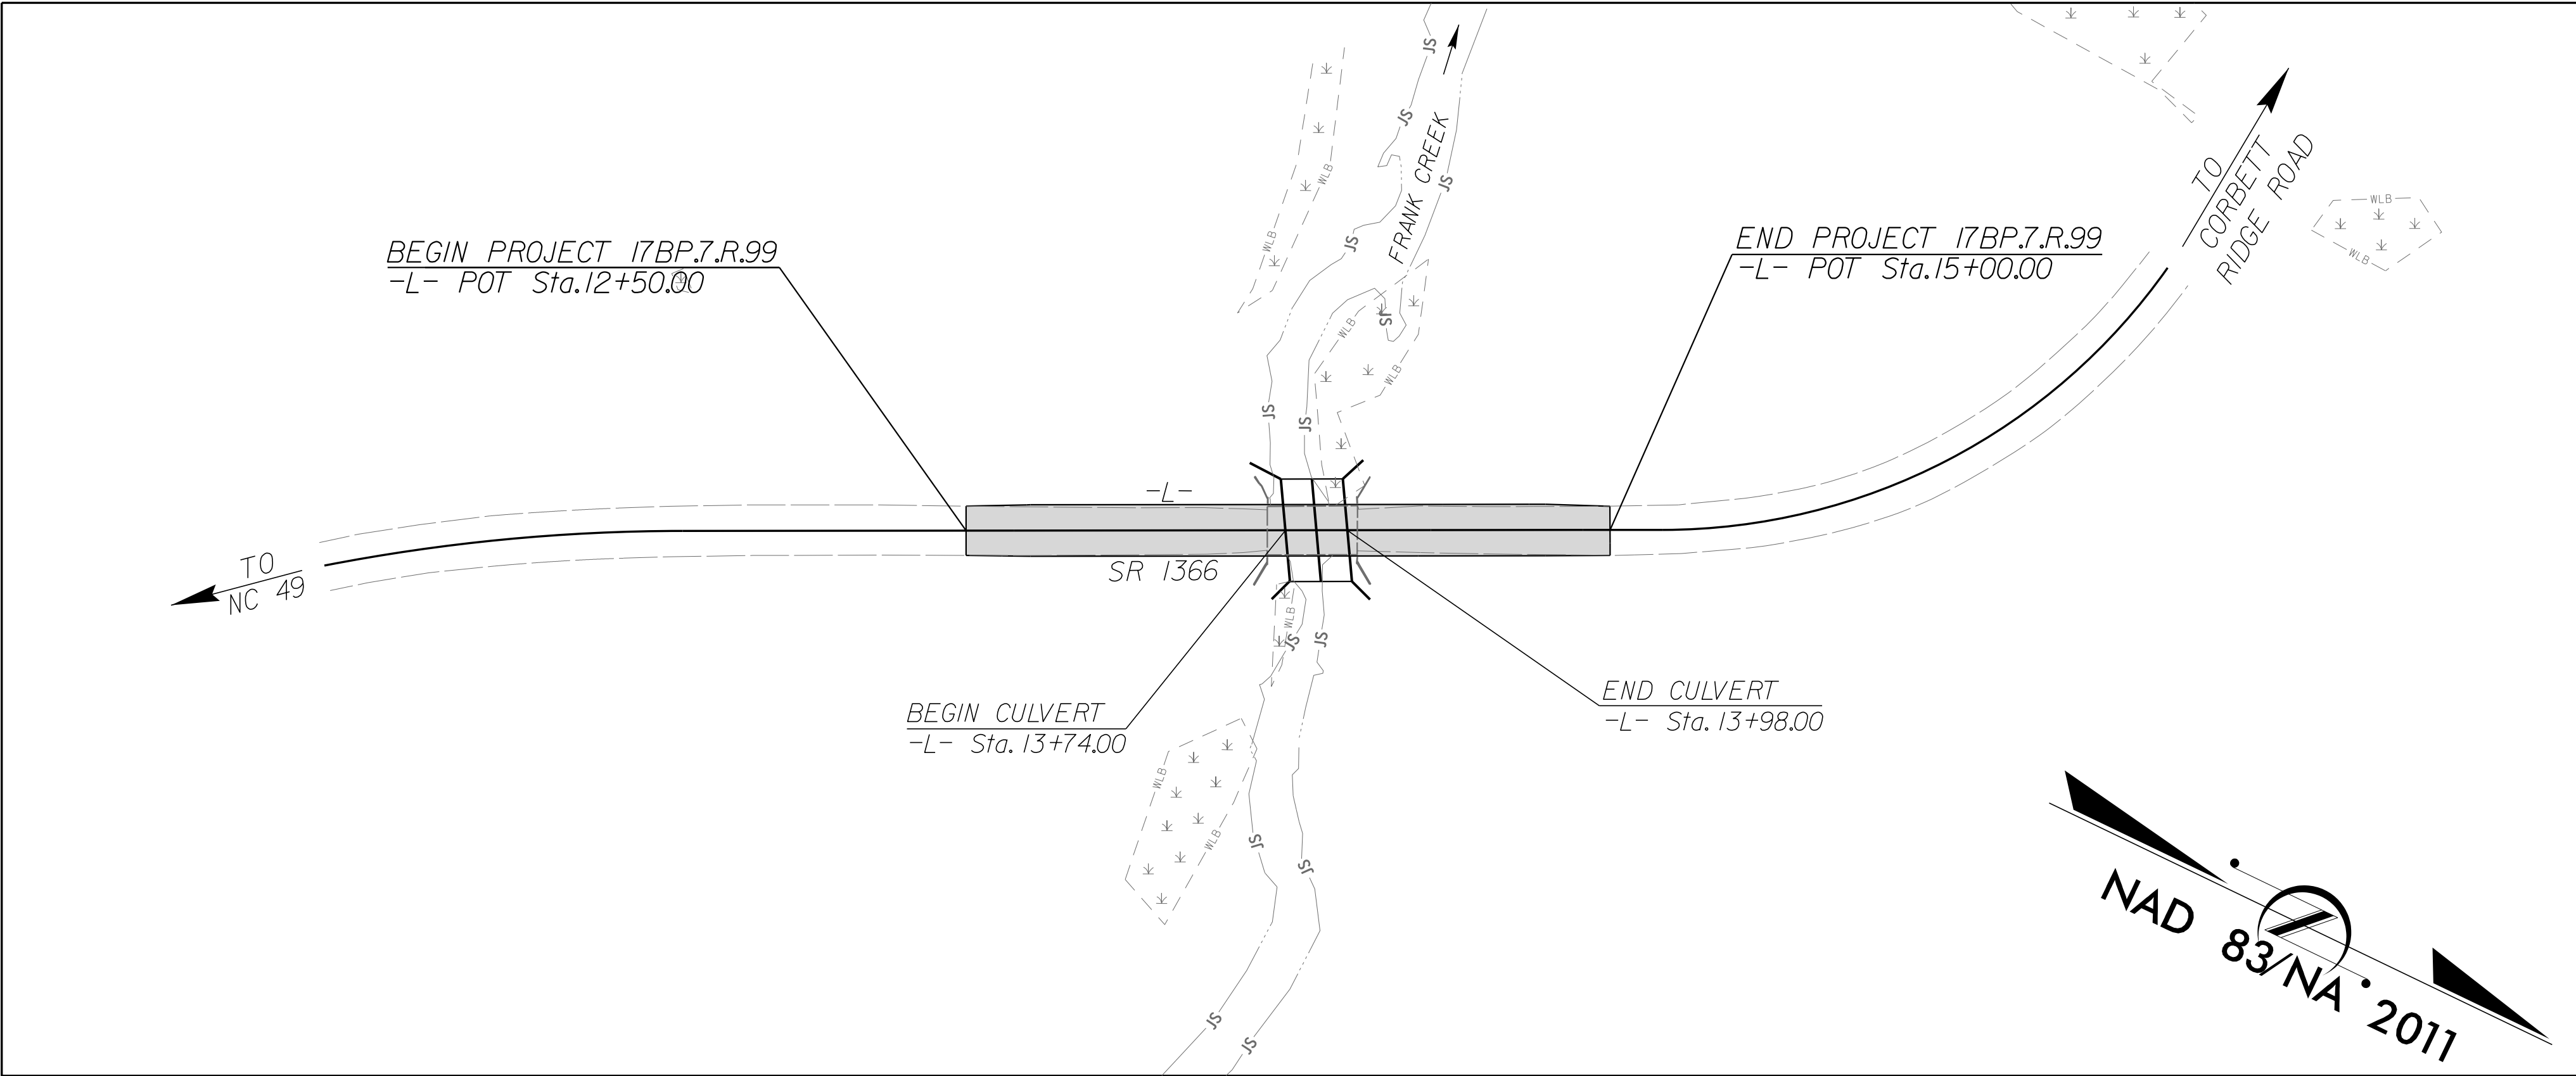

*DESIGN EXCEPTION:
SAG VERTICAL CURVE K
VERTICAL SSD

DOCUMENT NOT CONSIDERED FINAL
UNLESS ALL SIGNATURES COMPLETED

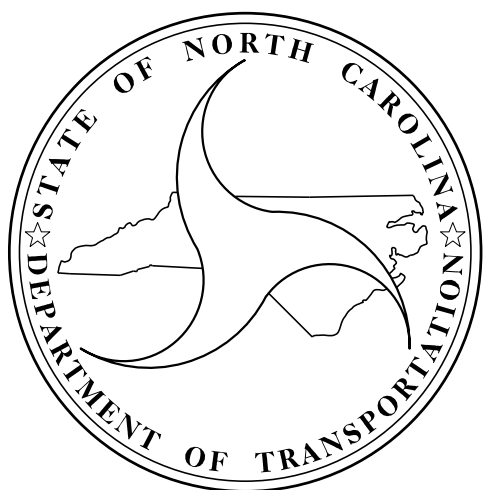

DESIGN DATA

ADT 2000 = 70

ADT 2025 = 140

V = 55 MPH

SUB REGIONAL TIER
LOCAL

PROJECT LENGTH

LENGTH ROADWAY TIP PROJECT = 0.042 MILES

LENGTH STRUCTURE TIP PROJECT = 0.005 MILES

TOTAL LENGTH TIP PROJECT = 0.047 MILES

Prepared In the Office of Hatch Mott MacDonald for
DIVISION 7
NORTH CAROLINA DEPARTMENT OF TRANSPORTATION

2012 STANDARD SPECIFICATIONS

LETTING DATE:


TIM JORDAN, PE
PROJECT ENGINEER

DAVID FUH, PE
HYDRAULICS ENGINEER

NCDOT CONTACT:


TIM POWERS, PE
DIVISION BRIDGE
PROGRAM MANAGER

ROADWAY DESIGN ENGINEER

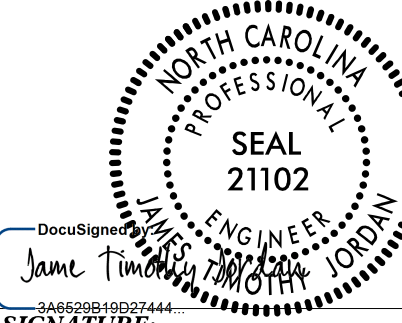

2/15/2017
P.E.

HYDRAULICS ENGINEER

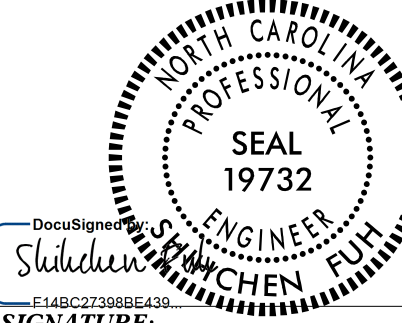

2/15/2017
P.E.

PLANS PREPARED BY:

M
MOTT
MACDONALD

PO Box 700
Fuquay-Varina, NC 27526
(919) 552-2253
(919) 552-2254 (Fax)
www.mottmac.com

LICENSE NO. F-0669

ICA
Engineering

5121 Kingdom Way,
Suite 100
Raleigh, NC 27607
NC License No: F-0258

GENERAL NOTES:

2012 SPECIFICATIONS
EFFECTIVE: 01-17-2012
REVISED: 10-31-2014

GRADE LINE:

GRADING AND SURFACING:

THE GRADE LINES SHOWN DENOTE THE FINISHED ELEVATION OF THE PROPOSED SURFACING AT GRADE POINTS SHOWN ON THE TYPICAL SECTIONS. GRADE LINES MAY BE ADJUSTED AT THEIR BEGINNING AND ENDING AND AT STRUCTURES AS DIRECTED BY THE ENGINEER IN ORDER TO SECURE A PROPER TIE-IN.

CLEARING:

CLEARING ON THIS PROJECT SHALL BE PERFORMED TO THE LIMITS ESTABLISHED BY METHOD II.

SUPERELEVATION:

ALL CURVES ON THIS PROJECT SHALL BE SUPERELEVATED IN ACCORDANCE WITH STD. NO. 225.04 USING THE RATE OF SUPERELEVATION AND RUNOFF SHOWN ON THE PLANS. SUPERELEVATION IS TO BE REVOLVED ABOUT THE GRADE POINTS SHOWN ON THE TYPICAL SECTIONS.

SHOULDER CONSTRUCTION:

ASPHALT, EARTH, AND CONCRETE SHOULDER CONSTRUCTION ON THE HIGH SIDE OF SUPERELEVATED CURVES SHALL BE IN ACCORDANCE WITH STD. NO. 560.01

GUARDRAIL:



THE GUARDRAIL LOCATIONS SHOWN ON THE PLANS MAY BE ADJUSTED DURING CONSTRUCTION AS DIRECTED BY THE ENGINEER. THE CONTRACTOR SHOULD CONSULT WITH THE ENGINEER PRIOR TO ORDERING GUARDRAIL MATERIAL.

SUBSURFACE PLANS:

NO SUBSURFACE PLANS ARE AVAILABLE ON THIS PROJECT. THE CONTRACTOR SHOULD MAKE HIS OWN INVESTIGATION AS TO THE SUBSURFACE CONDITIONS.

UTILITIES:

UTILITY OWNER ON THIS PROJECT IS CENTURY LINK.

PROJECT REFERENCE		SHEET NO.
17BP.7.R.99 – ORANGE 209		1-A
<div>ROADWAY DESIGN ENGINEER</div> <div></div> <div>MOTT MACDONALD I & E, LLC LICENSE NO. F-0669</div>		
DOCUMENT NOT CONSIDERED FINAL UNLESS ALL SIGNATURES COMPLETED		
Prepared in the Office of:		<div> MOTT MACDONALD</div> <div>PO Box 700 Fuquay-Varina, NC 27526 www.mottmac.com</div>

INDEX OF SHEETS	
SHEET NUMBER	DESCRIPTION
1	TITLE SHEET
1-A	INDEX OF SHEETS, GENERAL NOTES, AND LIST OF STANDARD DRAWINGS
1-B	CONVENTIONAL SYMBOLS
2	PAVEMENT SCHEDULE AND TYPICAL SECTIONS
3	GUARDRAIL & EARTHWORK SUMMARY
4	PLAN SHEET AND PROFILE SHEET
TMP-1 THRU TMP-3	TRAFFIC MANAGEMENT PLANS
EC-1 THRU EC-5	EROSION CONTROL PLANS
RF-1	REFORESTATION DETAIL SHEET
X-1 THRU X-3	CROSS-SECTIONS
C-1 THRU C-6	CULVERT PLANS
CN	STANDARD CULVERT NOTES

2012 ROADWAY ENGLISH STANDARD DRAWINGS

EFF. 01-17-2012
REV. 02-29-16

The following Roadway Standards as appear in "Roadway Standard Drawings" Highway Design Branch - N. C. Department of Transportation - Raleigh, N. C., Dated January, 2012 are applicable to this project and by reference hereby are considered a part of these plans:

STD.NO.	TITLE
DIVISION 2 – EARTHWORK	
200.02	Method of Clearing – Method II
225.02	Guide for Grading Subgrade – Secondary and Local
225.04	Method of Obtaining Superelevation – Two Lane Pavement
DIVISION 5 – SUBGRADE, BASES AND SHOULDERS	
560.01	Method of Shoulder Construction – High Side of Superelevated Curve – Method I
DIVISION 8 – INCIDENTALS	
862.01	Guardrail Placement
862.02	Guardrail Installation
876.01	Rip Rap in Channels
876.04	Drainage Ditches with Class 'B' Rip Rap

Note: Not to Scale

****S.U.E. = Subsurface Utility Engineering***

BOUNDARIES AND PROPERTY:

State Line	
County Line	
Township Line	
City Line	
Reservation Line	
Property Line	
Existing Iron Pin	
Property Corner	
Property Monument	
Parcel/Sequence Number	
Existing Fence Line	
Proposed Woven Wire Fence	
Proposed Chain Link Fence	
Proposed Barbed Wire Fence	
Existing Wetland Boundary	
Proposed Wetland Boundary	
Existing Endangered Animal Boundary	
Existing Endangered Plant Boundary	
Existing Historic Property Boundary	
Known Contamination Area: Soil	
Potential Contamination Area: Soil	
Known Contamination Area: Water	
Potential Contamination Area: Water	
Contaminated Site: Known or Potential	

BUILDINGS AND OTHER CULTURE:

Gas Pump Vent or U/G Tank Cap	
Sign	
Well	
Small Mine	
Foundation	
Area Outline	
Cemetery	
Building	
School	
Church	
Dam	

HYDROLOGY:

Stream or Body of Water	
Hydro, Pool or Reservoir	
Jurisdictional Stream	
Buffer Zone 1	
Buffer Zone 2	
Flow Arrow	
Disappearing Stream	
Spring	
Wetland	
Proposed Lateral, Tail, Head Ditch	
False Sump	

RAILROADS:

Standard Gauge	
RR Signal Milepost	
Switch	
RR Abandoned	
RR Dismantled	

RIGHT OF WAY:

Baseline Control Point	
Existing Right of Way Marker	
Existing Right of Way Line	
Proposed Right of Way Line	
Proposed Right of Way Line with Iron Pin and Cap Marker	
Proposed Right of Way Line with Concrete or Granite RW Marker	
Proposed Control of Access Line with Concrete C/A Marker	
Existing Control of Access	
Proposed Control of Access	
Existing Easement Line	
Proposed Temporary Construction Easement	
Proposed Temporary Drainage Easement	
Proposed Permanent Drainage Easement	
Proposed Permanent Drainage / Utility Easement	
Proposed Permanent Utility Easement	
Proposed Temporary Utility Easement	
Proposed Aerial Utility Easement	
Proposed Permanent Easement with Iron Pin and Cap Marker	

ROADS AND RELATED FEATURES:

Existing Edge of Pavement	
Existing Curb	
Proposed Slope Stakes Cut	
Proposed Slope Stakes Fill	
Proposed Curb Ramp	
Existing Metal Guardrail	
Proposed Guardrail	
Existing Cable Guiderail	
Proposed Cable Guiderail	
Equality Symbol	
Pavement Removal	

VEGETATION:

Single Tree	
Single Shrub	
Hedge	
Woods Line	

--	--

STATE OF NORTH CAROLINA
DIVISION OF HIGHWAYS

CONVENTIONAL PLAN SHEET SYMBOLS

Orchard	
Vineyard	

EXISTING STRUCTURES:

MAJOR:	
Bridge, Tunnel or Box Culvert	
Bridge Wing Wall, Head Wall and End Wall	
MINOR:	
Head and End Wall	
Pipe Culvert	
Footbridge	
Drainage Box: Catch Basin, DI or JB	
Paved Ditch Gutter	
Storm Sewer Manhole	
Storm Sewer	

UTILITIES:

POWER:	
Existing Power Pole	
Proposed Power Pole	
Existing Joint Use Pole	
Proposed Joint Use Pole	
Power Manhole	
Power Line Tower	
Power Transformer	
U/G Power Cable Hand Hole	
H-Frame Pole	
U/G Power Line LOS B (S.U.E.*)	
U/G Power Line LOS C (S.U.E.*)	
U/G Power Line LOS D (S.U.E.*)	

TELEPHONE:

Existing Telephone Pole	
Proposed Telephone Pole	
Telephone Manhole	
Telephone Pedestal	
Telephone Cell Tower	
U/G Telephone Cable Hand Hole	
U/G Telephone Cable LOS B (S.U.E.*)	
U/G Telephone Cable LOS C (S.U.E.*)	
U/G Telephone Cable LOS D (S.U.E.*)	
U/G Telephone Conduit LOS B (S.U.E.*)	
U/G Telephone Conduit LOS C (S.U.E.*)	
U/G Telephone Conduit LOS D (S.U.E.*)	
U/G Fiber Optics Cable LOS B (S.U.E.*)	
U/G Fiber Optics Cable LOS C (S.U.E.*)	
U/G Fiber Optics Cable LOS D (S.U.E.*)	


WATER:	
Water Manhole	
Water Meter	
Water Valve	
Water Hydrant	
U/G Water Line LOS B (S.U.E.*)	
U/G Water Line LOS C (S.U.E.*)	
U/G Water Line LOS D (S.U.E.*)	
Above Ground Water Line	

TV:	
TV Pedestal	
TV Tower	
U/G TV Cable Hand Hole	
U/G TV Cable LOS B (S.U.E.*)	
U/G TV Cable LOS C (S.U.E.*)	
U/G TV Cable LOS D (S.U.E.*)	
U/G Fiber Optic Cable LOS B (S.U.E.*)	
U/G Fiber Optic Cable LOS C (S.U.E.*)	
U/G Fiber Optic Cable LOS D (S.U.E.*)	

GAS:	
Gas Valve	
Gas Meter	
U/G Gas Line LOS B (S.U.E.*)	
U/G Gas Line LOS C (S.U.E.*)	
U/G Gas Line LOS D (S.U.E.*)	
Above Ground Gas Line	

SANITARY SEWER:	
Sanitary Sewer Manhole	
Sanitary Sewer Cleanout	
U/G Sanitary Sewer Line	
Above Ground Sanitary Sewer	
SS Forced Main Line LOS B (S.U.E.*)	
SS Forced Main Line LOS C (S.U.E.*)	
SS Forced Main Line LOS D (S.U.E.*)	

MISCELLANEOUS:	
Utility Pole	
Utility Pole with Base	
Utility Located Object	
Utility Traffic Signal Box	
Utility Unknown U/G Line LOS B (S.U.E.*)	
U/G Tank; Water, Gas, Oil	
Underground Storage Tank, Approx. Loc.	
A/G Tank; Water, Gas, Oil	
Geoenvironmental Boring	
U/G Test Hole LOS A (S.U.E.*)	
Abandoned According to Utility Records	
End of Information	

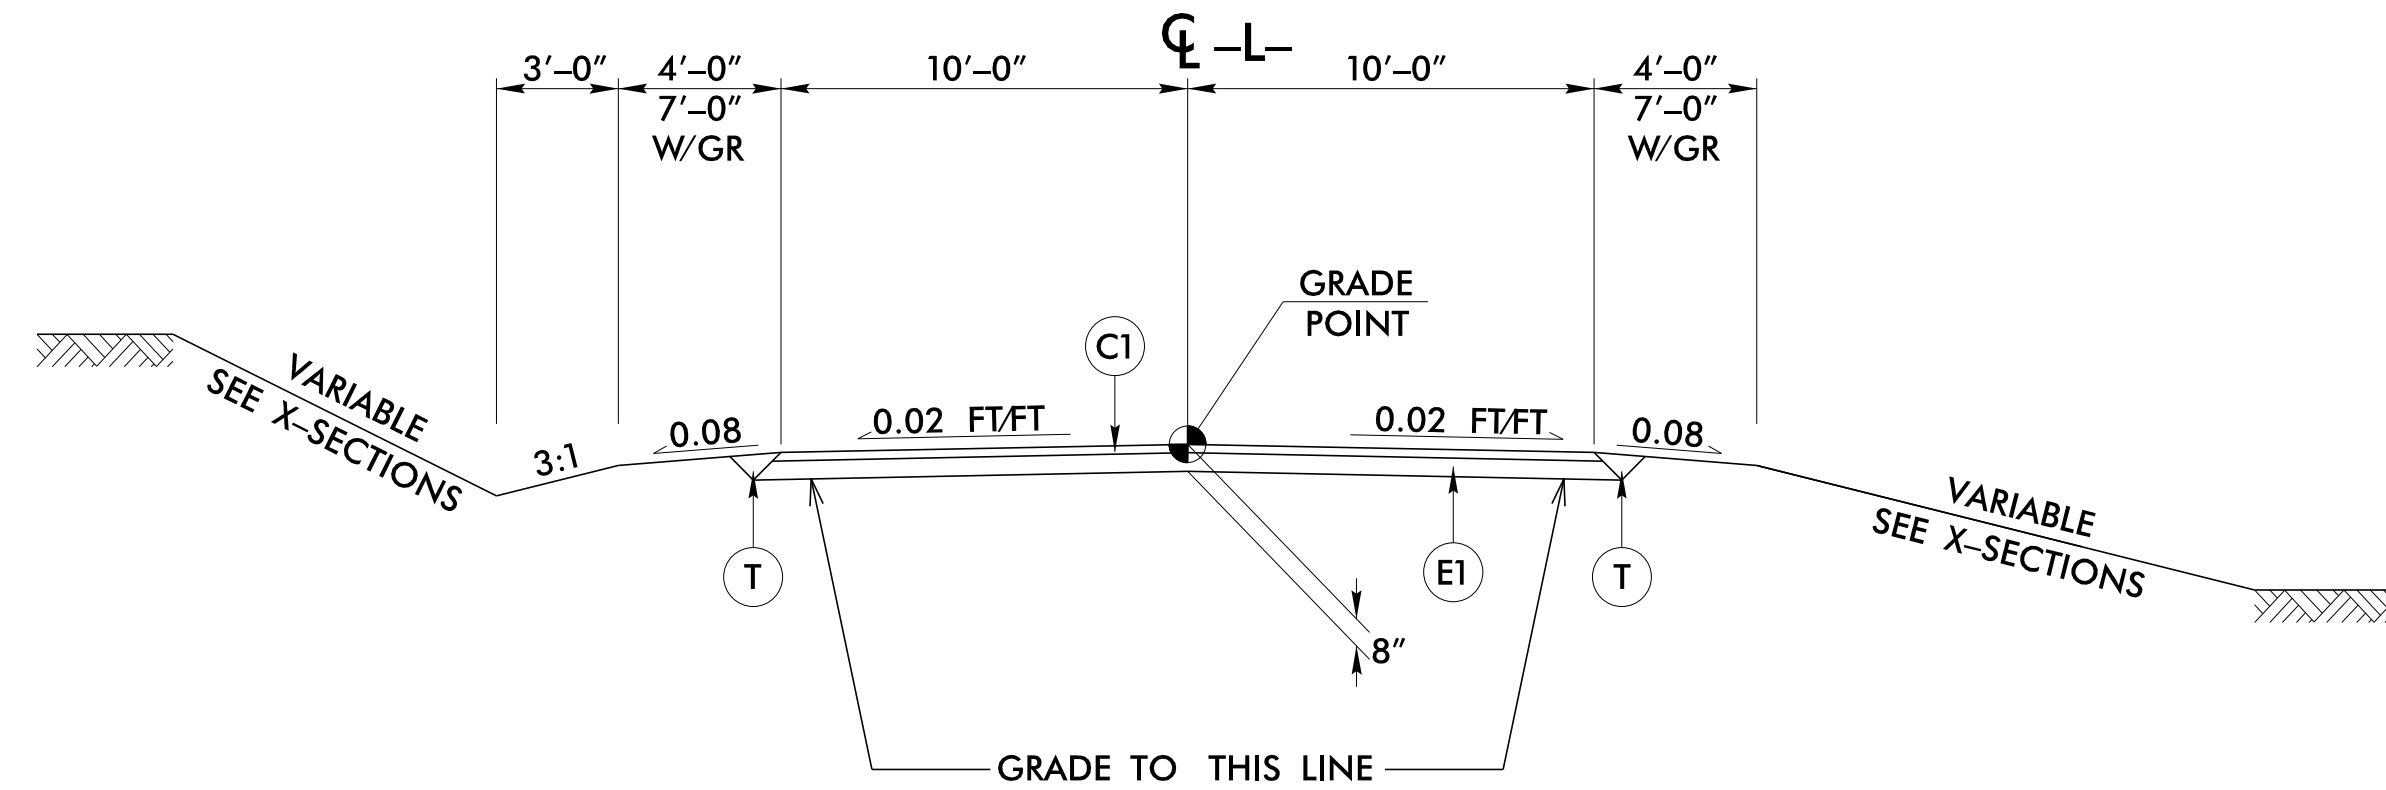

TYPICAL SECTION NO. 1

TRANSITION FROM EXISTING TO TYPICAL SECTION NO. 1:
-L- STA 12+50.00 TO 12+75.00


USE TYPICAL SECTION NO. 1:
-L- STA 12+75.00 TO 14+75.00

TRANSITION FROM TYPICAL SECTION NO. 1 TO EXISTING:
-L- STA 14+75.00 TO 15+00.00

PAVEMENT SCHEDULE	
C1	PROP. APPROX. 2½" ASPHALT CONCRETE SURFACE COURSE, TYPE SF9.5A, AT AN AVERAGE RATE OF 137.5 LBS. PER SQ. YD. IN EACH OF TWO LAYERS.
E1	PROP. APPROX. 5½" ASPHALT CONCRETE BASE COURSE, TYPE B25.0B, AT AN AVERAGE RATE OF 627 LBS. PER SQ. YD.
T	EARTH MATERIAL.

NOTE: PAVEMENT EDGE SLOPES ARE 1:1 UNLESS SHOWN OTHERWISE.

Jor66165
R:\Roadway\Proj\670209_rdy-ty.p.dgn
2/15/2017 2:03:16 PM

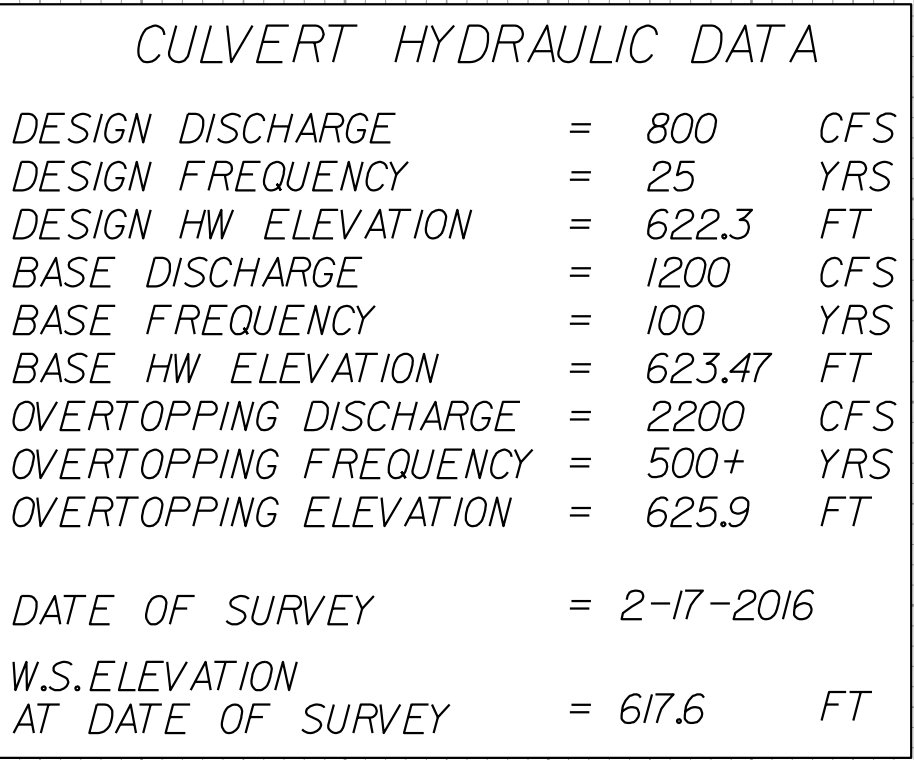

THE FOLLOWING ROADWAY STANDARDS AS APPEAR IN "ROADWAY STANDARD DRAWINGS" – HIGHWAY DESIGN BRANCH– N.C. DEPARTMENT OF TRANSPORTATION – RALEIGH, N.C., DATED JANUARY 2012 ARE APPLICABLE TO THIS PROJECT AND BY REFERENCE HEREBY ARE CONSIDERED A PART OF THESE PLANS:

STD.	TITLE
1101.03	TEMPORARY ROAD CLOSURES
1110.01	STATIONARY WORK ZONE SIGNS
1145.01	BARRICADES
1205.01	PAVEMENT MARKINGS – LINE TYPES AND OFFSETS
1205.02	PAVEMENT MARKINGS – TWO–LANE AND MULTI–LANE ROADWAYS
1205.12	PAVEMENT MARKINGS – BRIDGES
1261.01	GUARDRAIL AND BARRIER DELINEATORS – INSTALLATION SPACING
1261.02	GUARDRAIL AND BARRIER DELINEATORS – TYPES AND MOUNTING
1262.01	GUARDRAIL END DELINEATION

GENERAL NOTES

CHANGES MAY BE REQUIRED WHEN PHYSICAL DIMENSIONS IN THE DETAIL DRAWINGS, STANDARD DETAILS, AND ROADWAY DETAILS ARE NOT ATTAINABLE TO MEET FIELD CONDITIONS OR RESULT IN DUPLICATE OR UNDESIREED OVERLAPPING OF DEVICES. MODIFICATION MAY INCLUDE: MOVING, SUPPLEMENTING, COVERING, OR REMOVAL OF DEVICES AS DIRECTED BY THE ENGINEER.

THE FOLLOWING GENERAL NOTES APPLY AT ALL TIMES FOR THE DURATION OF THE CONSTRUCTION PROJECT EXCEPT WHEN OTHERWISE NOTED IN THE PLAN OR DIRECTED BY THE ENGINEER.

TRAFFIC PATTERN ALTERATIONS

A) NOTIFY THE ENGINEER TWENTY ONE (21) CALENDAR DAYS PRIOR TO ANY TRAFFIC PATTERN ALTERATION.

SIGNING

B) PROVIDE PERMANENT SIGNING.

C) PROVIDE SIGNING AND DEVICES REQUIRED TO CLOSE THE ROAD ACCORDING TO THE ROADWAY STANDARD DRAWINGS AND TRAFFIC CONTROL PLANS.

PROVIDE SIGNING REQUIRED FOR THE OFF–SITE DETOUR ROUTE AS SHOWN IN THE TRAFFIC CONTROL PLANS.

D) COVER OR REMOVE ALL SIGNS AND DEVICES REQUIRED TO CLOSE THE ROAD WHEN ROAD CLOSURE IS NOT IN OPERATION.

COVER OR REMOVE ALL SIGNS REQUIRED FOR THE OFF–SITE DETOUR WHEN THE DETOUR IS NOT IN OPERATION.


E) ENSURE ALL NECESSARY SIGNING IS IN PLACE PRIOR TO ALTERING ANY TRAFFIC PATTERN.

TRAFFIC CONTROL DEVICES

F) PLACE TYPE III BARRICADES, WITH "ROAD CLOSED" SIGN R11–2 ATTACHED, OF SUFFICIENT LENGTH TO CLOSE ENTIRE ROADWAY.

PAVEMENT MARKINGS AND MARKERS

G) INSTALL PAVEMENT MARKINGS ON THE FINAL SURFACE.

PROJECT REFERENCE		SHEET NO.	
17BP.7.R.99 – ORANGE 209		TMP–1	
ROADWAY DESIGN ENGINEER  TIMOTHY MOTT MACDONALD 2/15/2017			
DOCUMENT NOT CONSIDERED FINAL UNLESS ALL SIGNATURES COMPLETED			
Prepared in the Office of:		MOTT MACDONALD PO Box 700 Fuquay–Varina, NC 27526 www.mottmac.com	

PHASING

STEP 1: USING ROADWAY STANDARD DRAWING NUMBER 1101.03, SHEET 1 OF 9, AND SHEET TMP–2, PERFORM THE FOLLOWING:
– INSTALL ALL ROAD CLOSURE AND DETOUR SIGNING INCLUDING BARRICADES
– CLOSE SR 1366 (ATKINS ROAD)
– PLACE TRAFFIC ONTO OFF– SITE DETOUR

STEP 2: REMOVE EXISTING BRIDGE #209 AND CONSTRUCT THE PROPOSED CULVERT AND APPROACHES AS SHOWN IN THE CONSTRUCTION PLANS.


STEP 3: INSTALL FINAL PAVEMENT MARKINGS.

STEP 4: REMOVE ALL TRAFFIC CONTROL SIGNING AND DEVICES AND RE–OPEN SR 1366 (ATKINS ROAD) TO THE FINAL TRAFFIC PATTERN.


PAVEMENT MARKING

PAINT WHITE EDGELINE (4") 1,000 LF
PAINT YELLOW DOUBLE CENTER (4") 1,000 LF

NOTE: QUANTITY INCLUDES 2 APPLICATIONS OF EACH

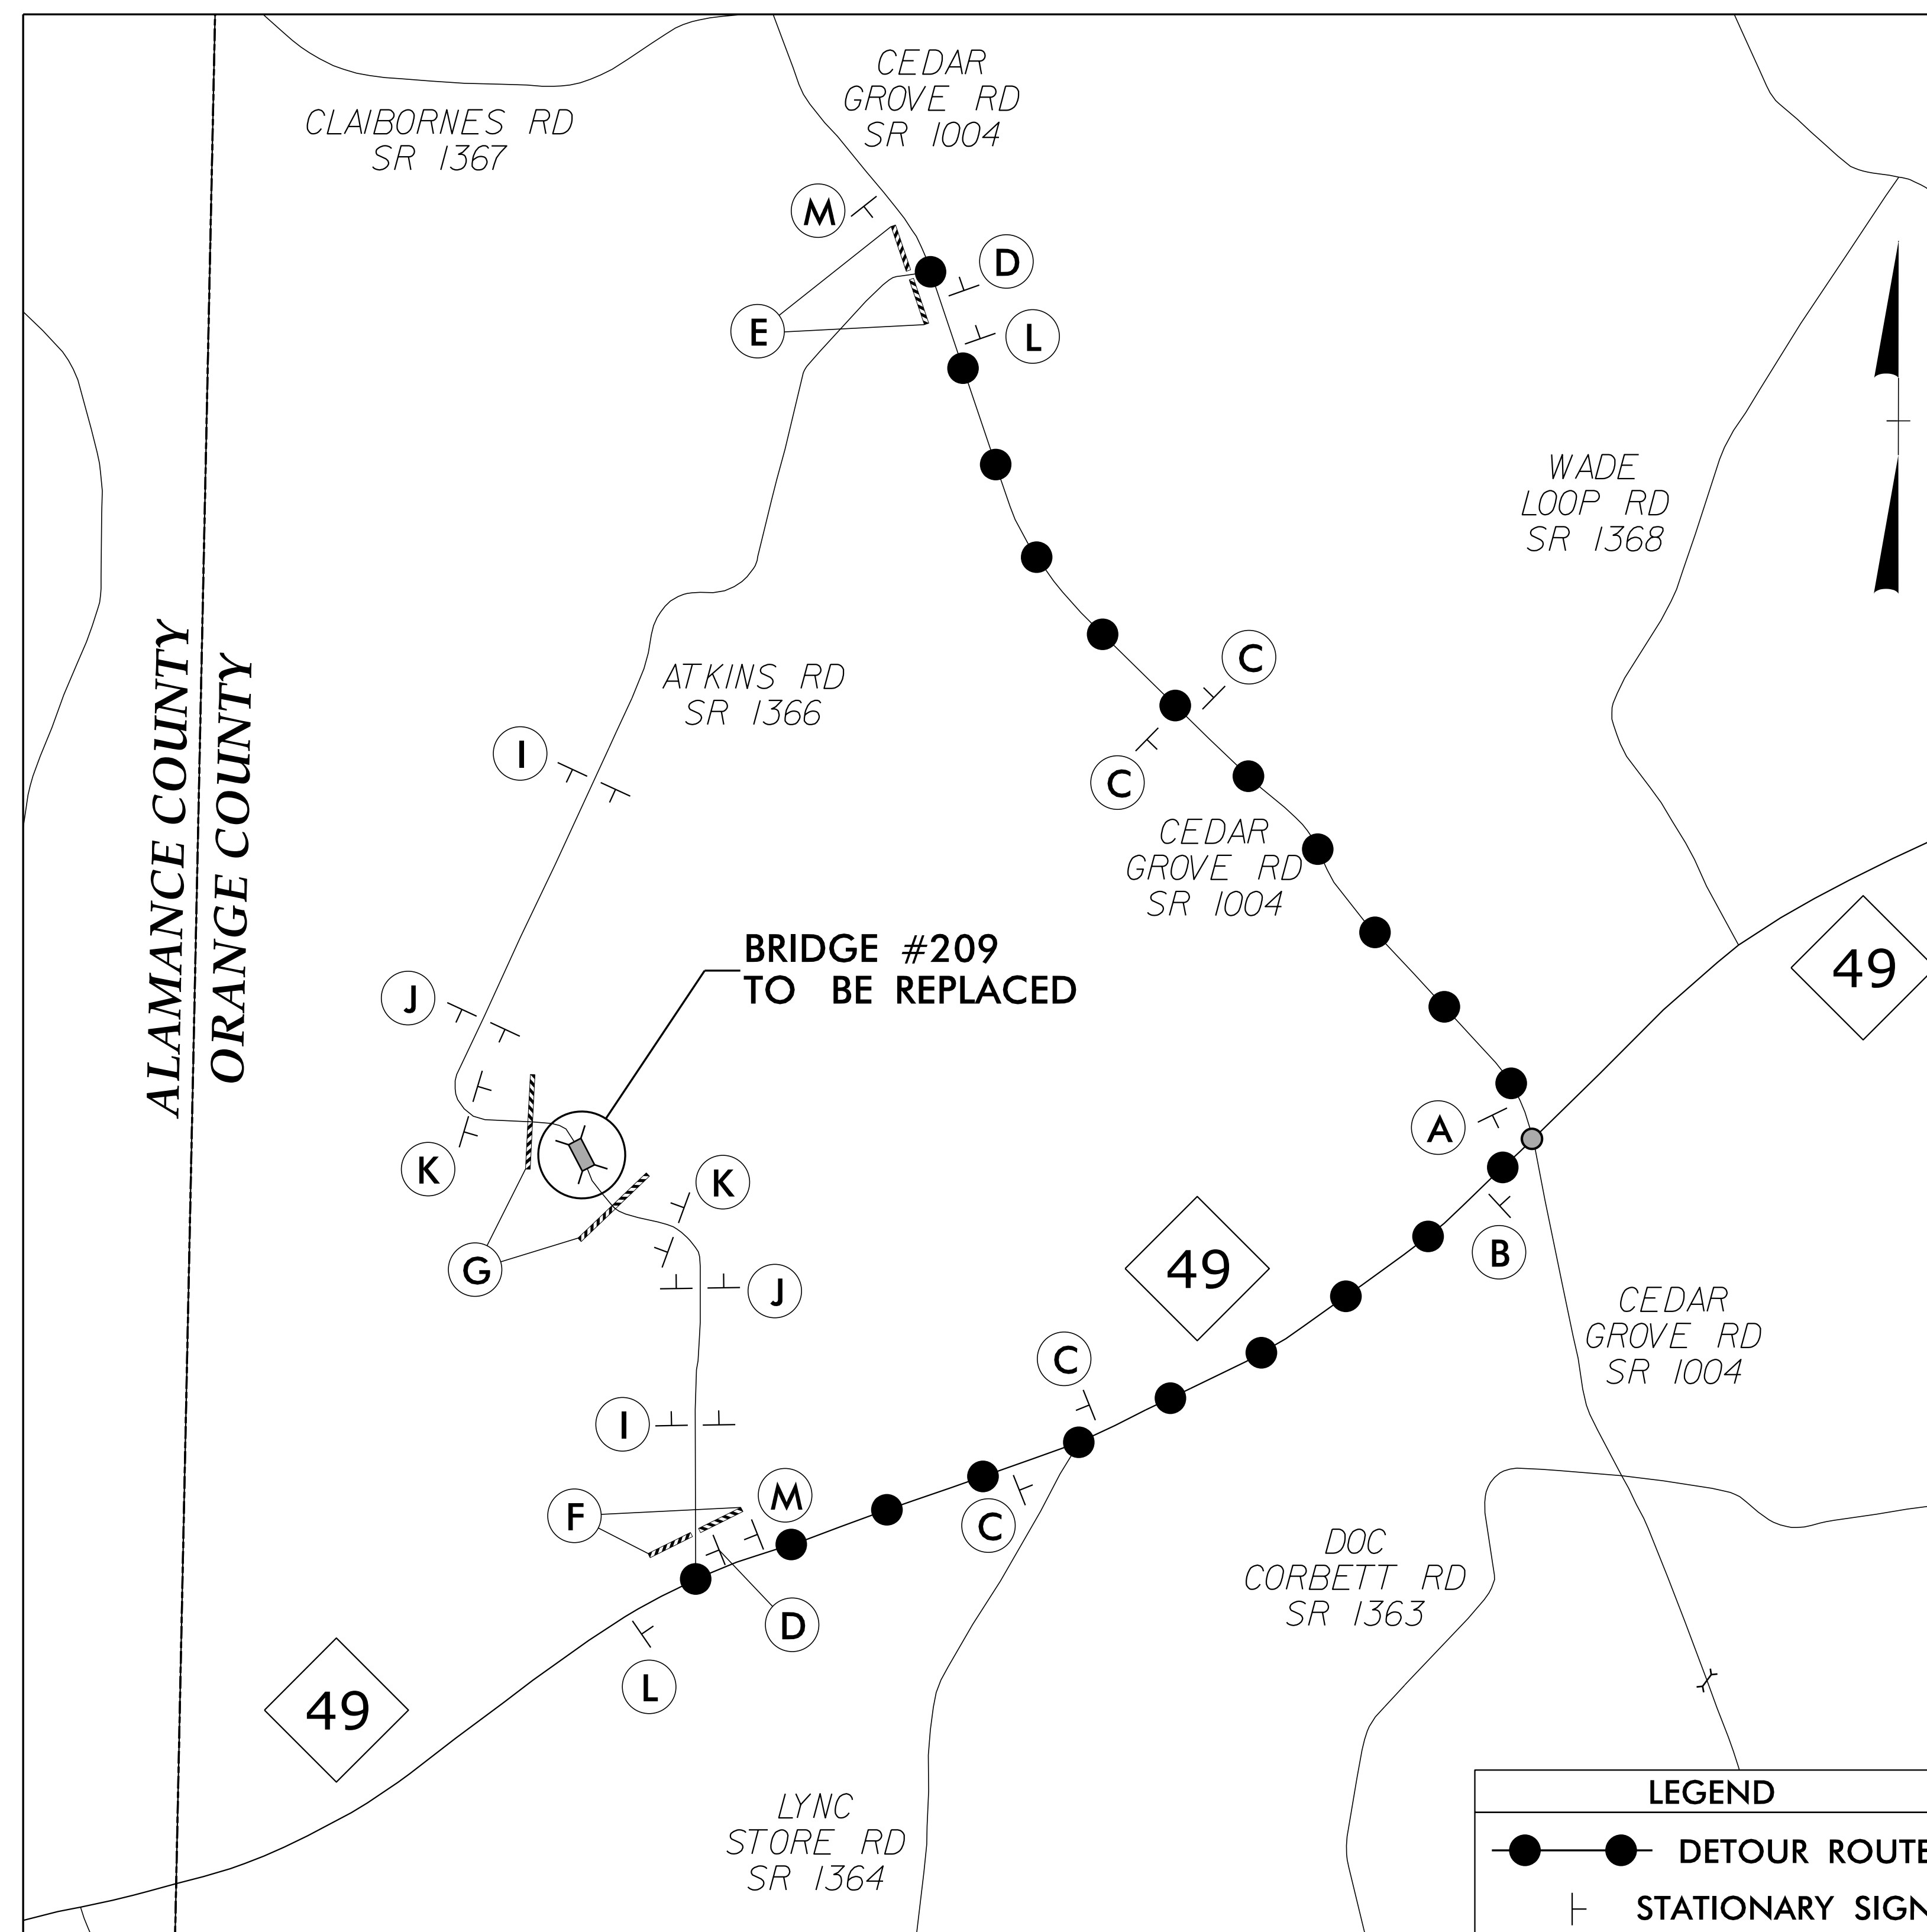

* SEE SHEET TMP-3 FOR SPECIAL SIGN DESIGNS

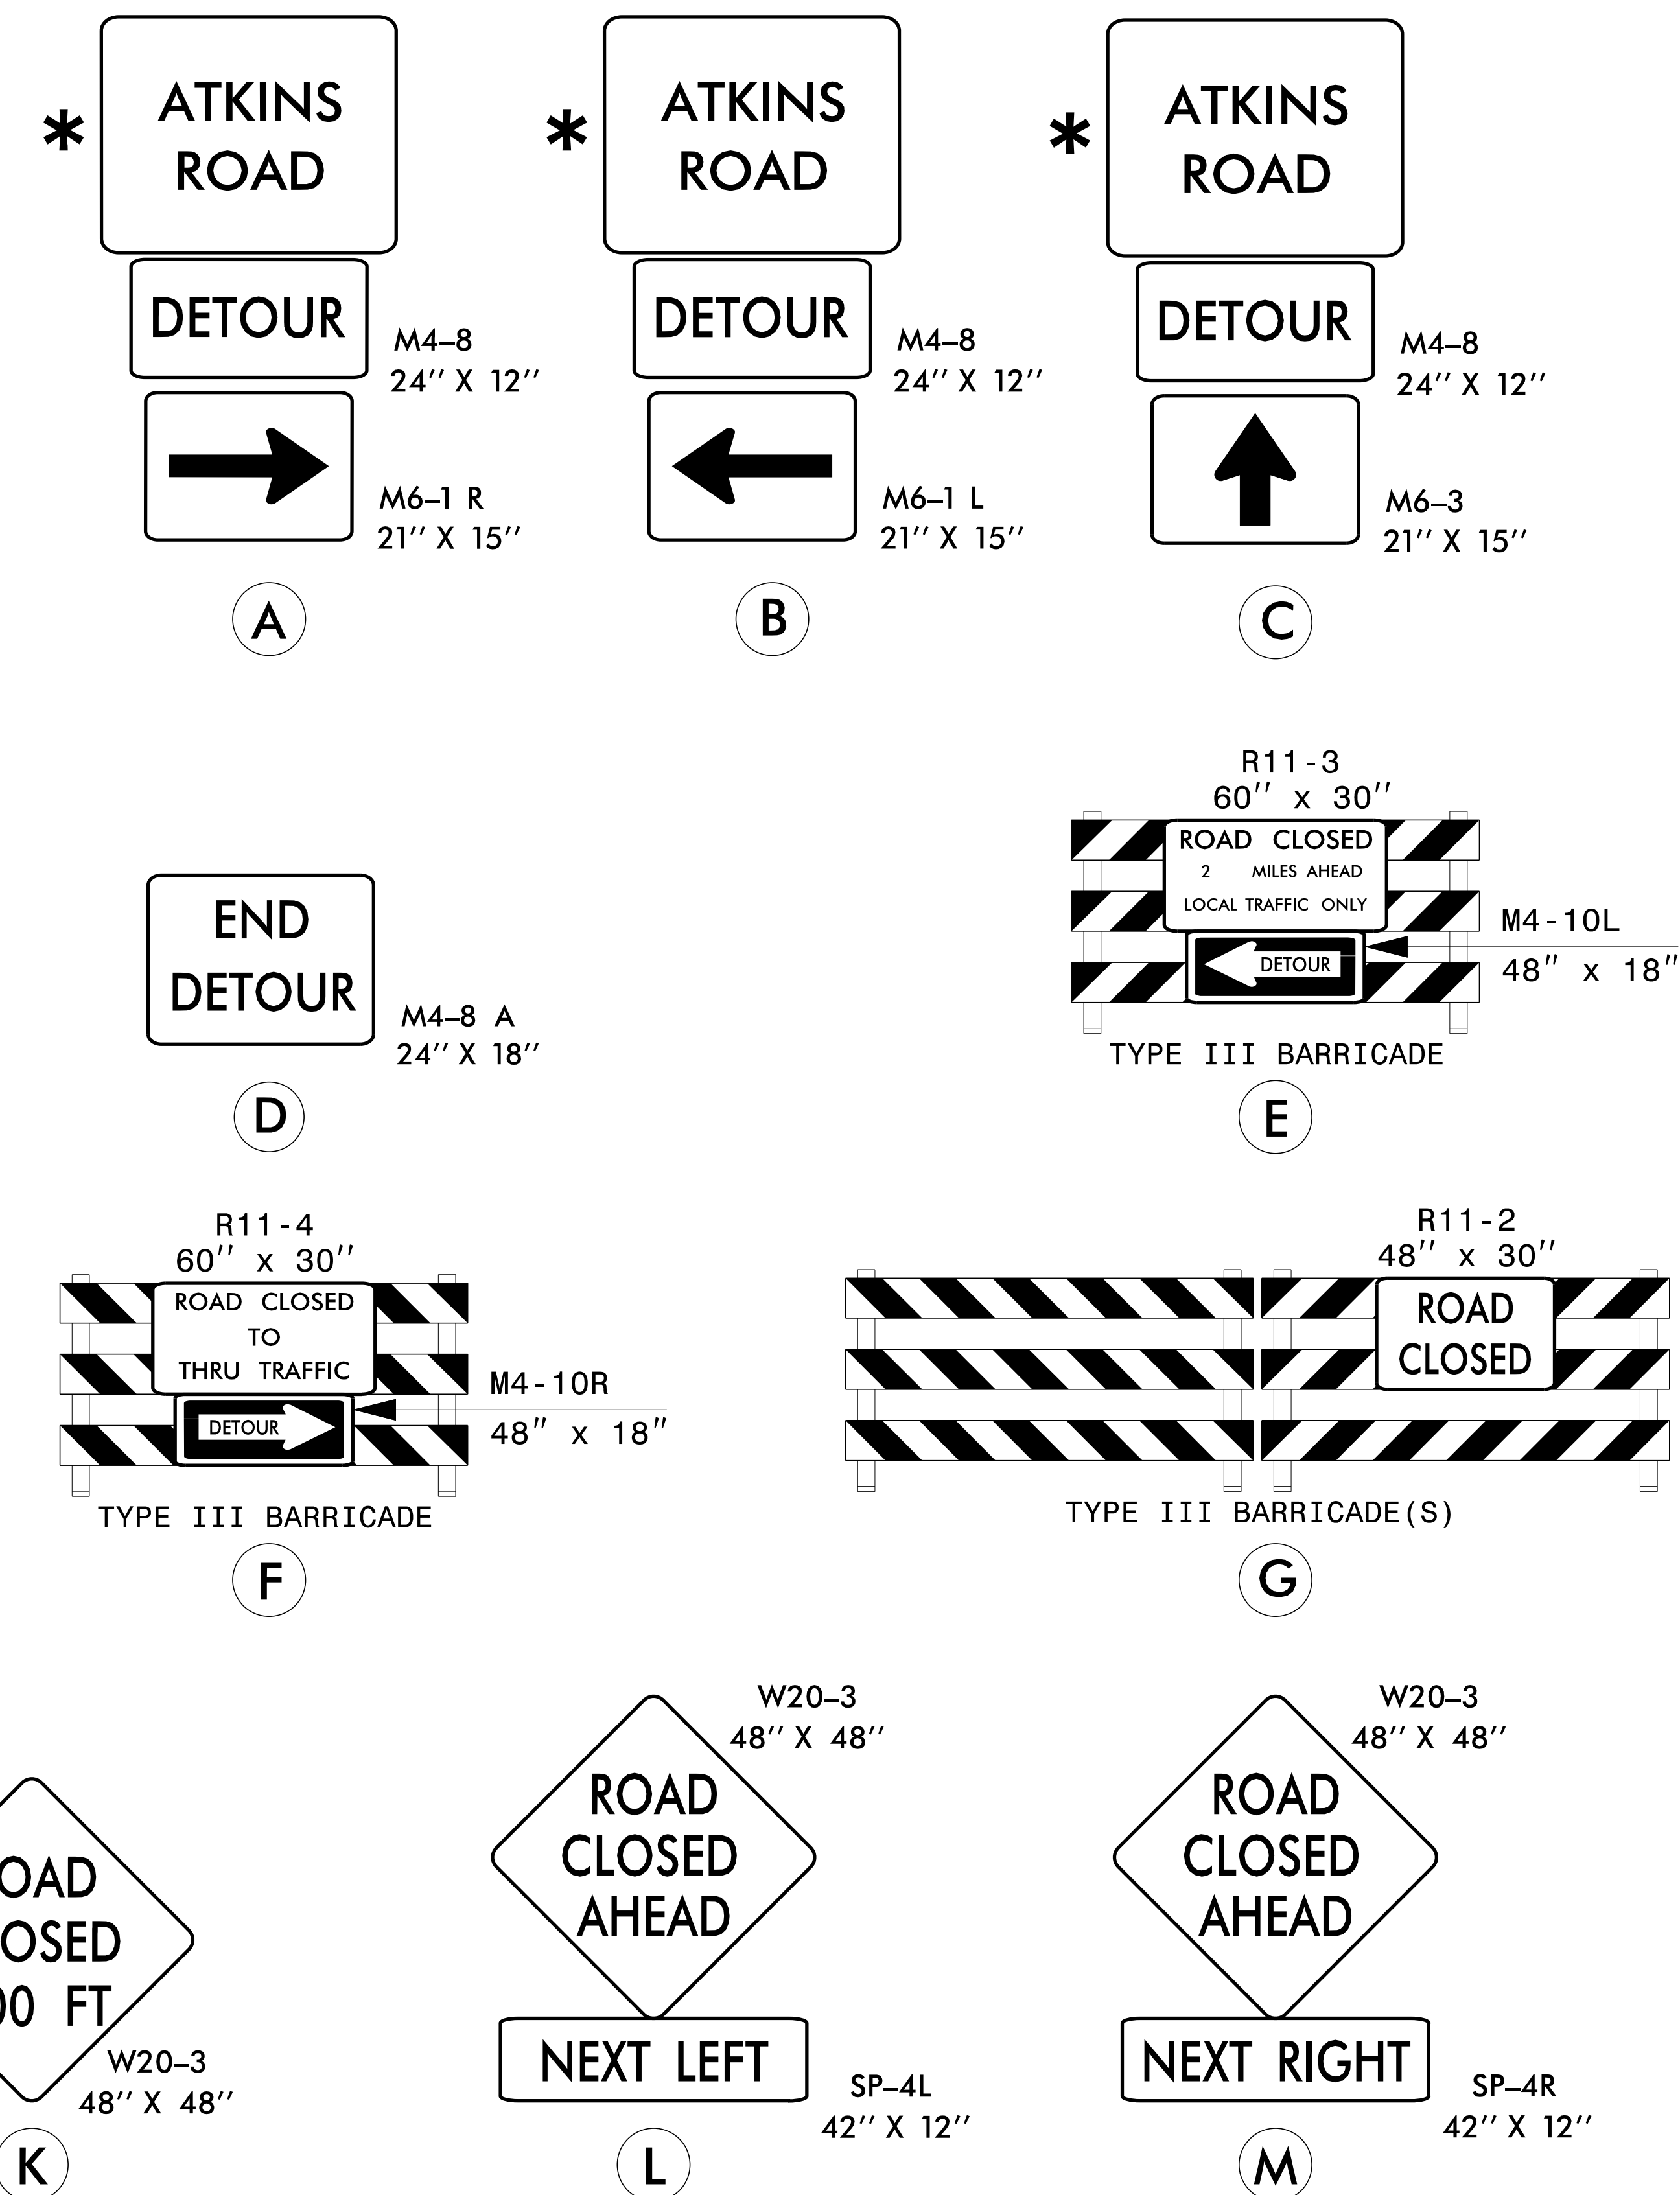

for66165
R:\Roadway\Proj\670209_rdy_tmp.dgn
2/15/2017 2:03:22 PM

SIGN NUMBER: SD-1

TYPE: D

QUANTITY: SEE PLANS

SIGN WIDTH: 3'-0"

HEIGHT: 2'-6"

TOTAL AREA: 7.5 Sq.Ft.

BORDER TYPE: INSET

RECESS: 0.38"

WIDTH: 0.5"

RADII: 1.5"

NO. Z BARS:

LENGTH:

BACKG COLOR: Fluorescent Orange

COPY COLOR: Black

SYMBOL	X	Y	WID	HT

MAT'L: 0.080" (2.0 mm) ALUMINUM

DESIGN BY: PJ

PROJECT ID: 17BP.7.R.99

CHECKED BY: NKP

DIV: 7

DATE: Oct 20, 2015

3'-0"

2'-6"

6.75"

6"

4.5"

6"

6.75"

6.8"

22.4"

6.8"

ATKINS ROAD

BORDER

R=1.5"

TH=0.5"

IN=0.38"

Spacing Factor is 1 unless specified otherwise

LETTER POSITIONS


Letter locations are panel edge to lower left corner																				Series/Size	
																				Text	Length
A	T	K	I	N	S															C 2000	
6.8	11	14.9	19.3	21.5	25.8															22.4	
R	O	A	D																	C 2000	
9.7	14	18.2	22.9																	16.6	

FILENAME: 670018_rdy_tmp3

NORTH CAROLINA D.O.T. SIGN DETAIL

2/21/2017 1:50:00 PM C:\Users\stahd\OneDrive\Documents\17BP.7.R.99\17BP.7.R.99.dgn

TIP PROJECT: 17BP.7.R.99

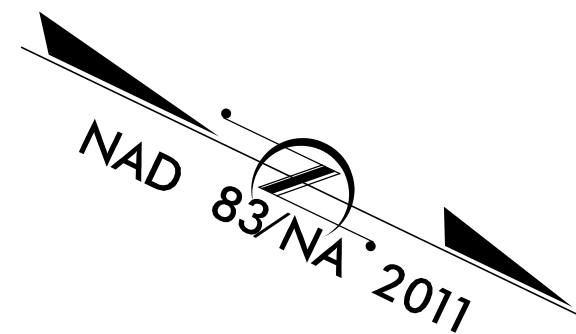

STACEY H. BAILEY, P.E.
ROADSIDE ENVIRONMENTAL ENGINEER

3074
LEVEL III CERTIFICATION NUMBER


KYLE STOFFER, E.I.
ROADSIDE ENVIRONMENTAL PROJECT ENGINEER

3844
LEVEL III CERTIFICATION NUMBER

STATE OF NORTH CAROLINA
DIVISION OF HIGHWAYS
PLAN FOR PROPOSED
HIGHWAY EROSION CONTROL
ORANGE COUNTY

LOCATION: BRIDGE NO. 209 OVER FRANK CREEK ON SR 1366 (ATKINS ROAD)

TYPE OF WORK: GRADING, PAVING, DRAINAGE AND CULVERT

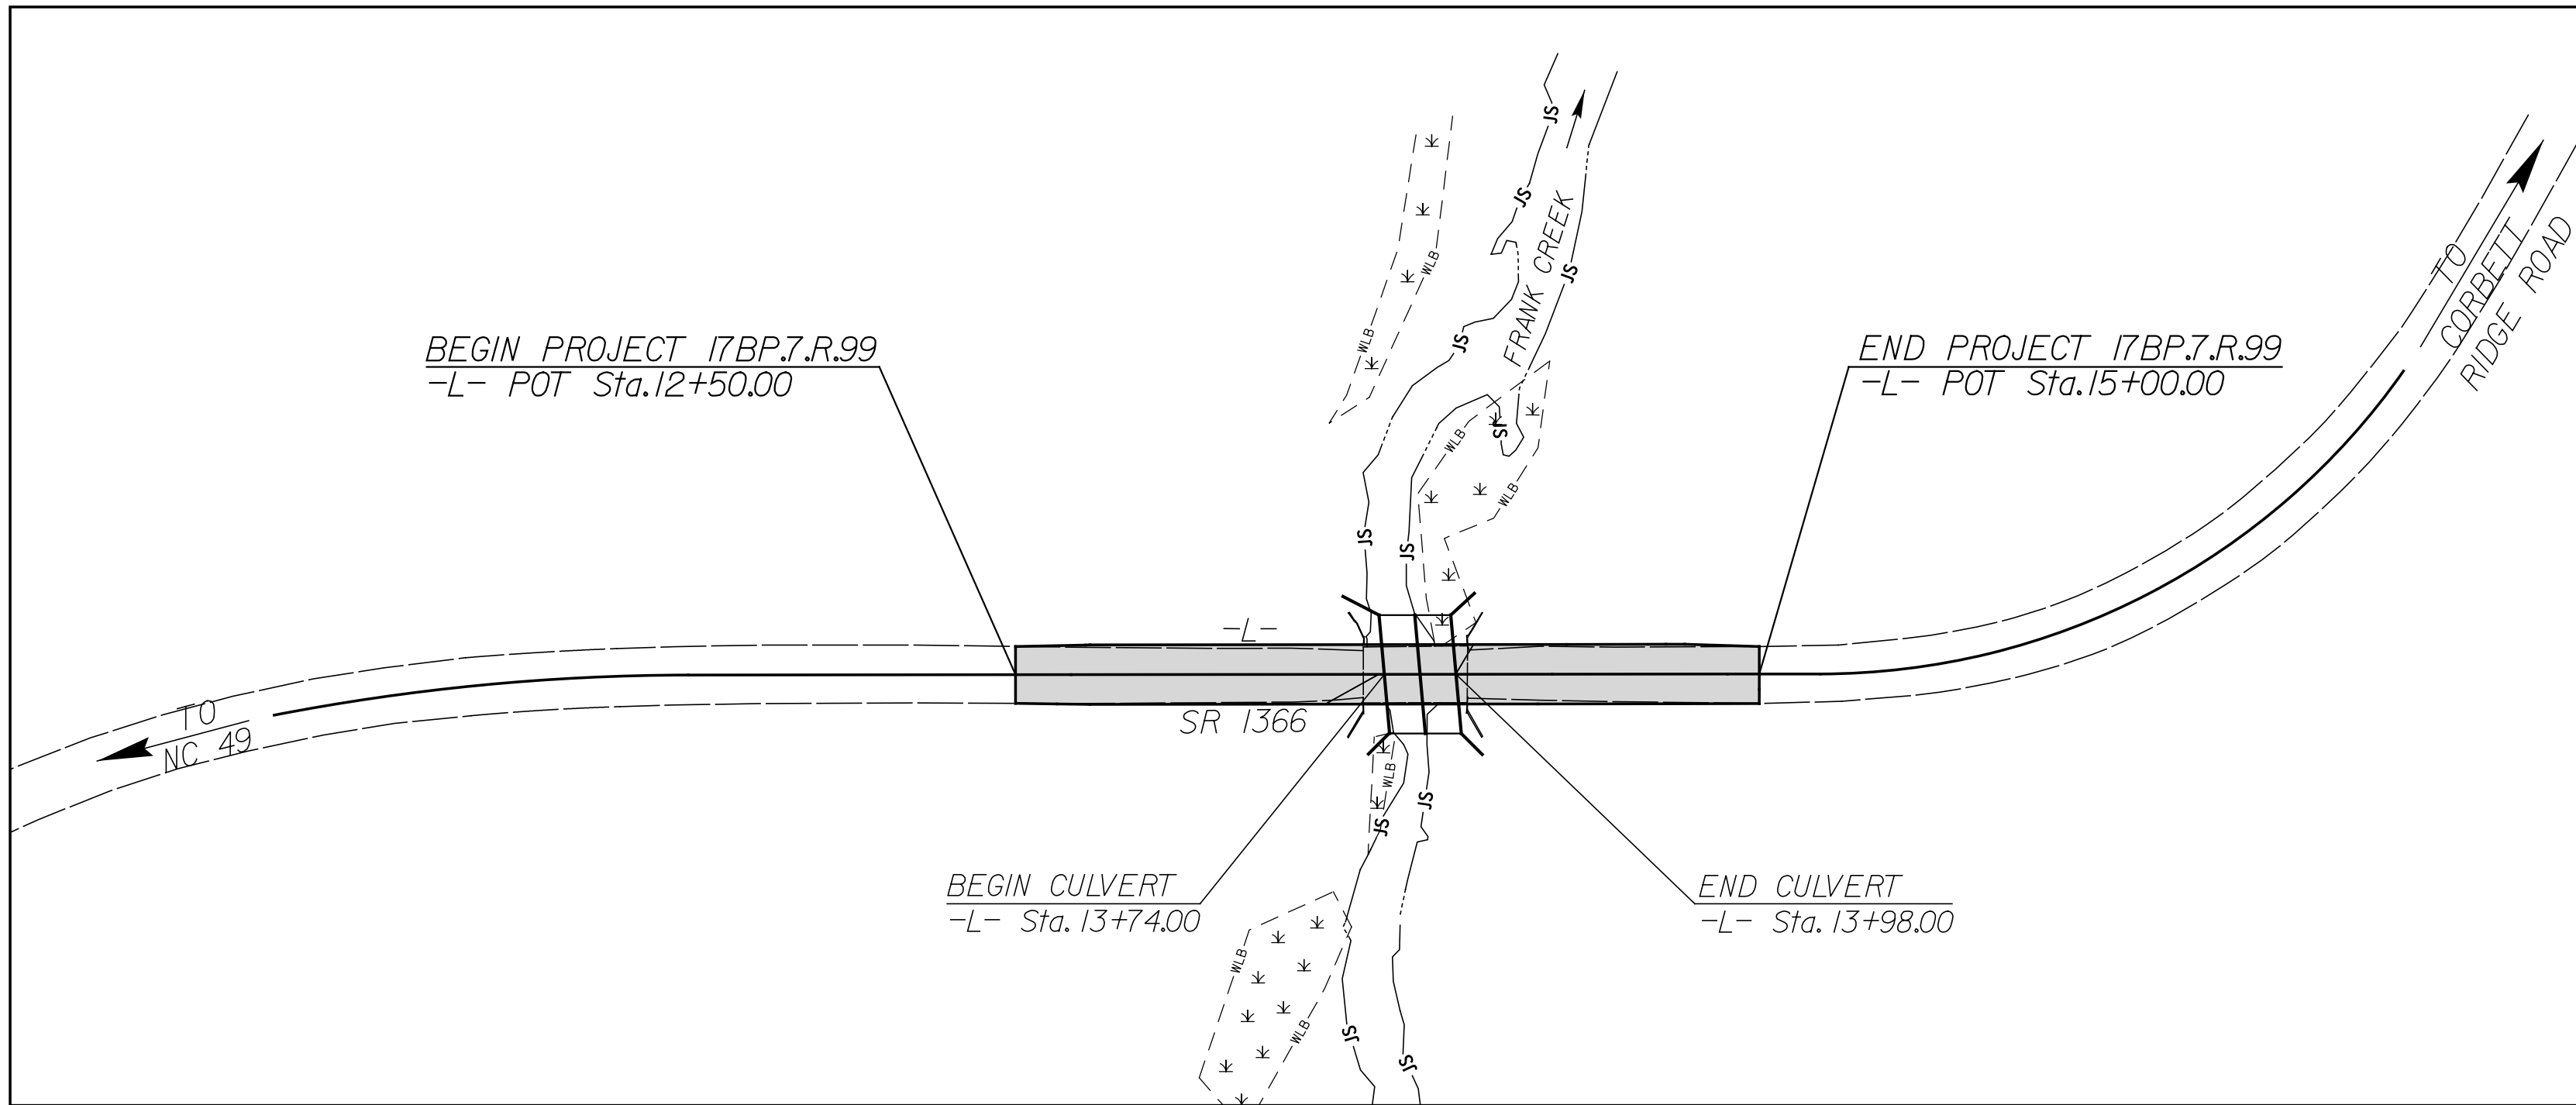

STATE	STATE PROJECT REFERENCE NO.	SHEET NO.	TOTAL SHEETS
N.C.	17BP.7.R.99	EC-1	
STATE PROJ. NO.	F.A. PROJ. NO.	DESCRIPTION	

EROSION AND SEDIMENT CONTROL MEASURES

Std. #	Description	Symbol
1630.03	Temporary Silt Ditch	TSB
1630.05	Temporary Diversion	TD
1605.01	Temporary Silt Fence	TSF
1606.01	Special Sediment Control Fence	SSCF
1622.01	Temporary Berms and Slope Drains	TBSD
1630.02	Silt Basin Type B	SB
1633.01	Temporary Rock Silt Check Type-A	TRSCA
	Temporary Rock Silt Check Type-A with Matting and Polyacrylamide (PAM)	TRSCA-PAM
1633.02	Temporary Rock Silt Check Type-B	TRSCB
	Wattle/Coir Fiber Wattle	W/CFW
	Wattle/Coir Fiber Wattle with Polyacrylamide (PAM)	W/CFW-PAM
1634.01	Temporary Rock Sediment Dam Type-A	TRSDA
1634.02	Temporary Rock Sediment Dam Type-B	TRSDA-B
1635.01	Rock Pipe Inlet Sediment Trap Type-A	RPIST-A
1635.02	Rock Pipe Inlet Sediment Trap Type-B	RPIST-B
1630.04	Stilling Basin	SB
1630.06	Special Stilling Basin	SSB
	Rock Inlet Sediment Trap:	
1632.01	Type A	A
1632.02	Type B	B
1632.03	Type C	C
	Skimmer Basin	SB
	Tiered Skimmer Basin	TSB
	Infiltration Basin	IB

THIS PROJECT CONTAINS
EROSION CONTROL PLANS
FOR CLEARING AND
GRUBBING PHASE OF
CONSTRUCTION.

THIS PROJECT HAS
BEEN DESIGNED TO
SENSITIVE WATERSHED
STANDARDS.


ENVIRONMENTALLY
SENSITIVE AREA(S) EXIST
ON THIS PROJECT

Refer To E. C. Special Provisions
for Special Considerations.


HIGH QUALITY WATER(S) EXIST
ON THIS PROJECT

High Quality Water Zone(s) Exist
From Sta. 12+50 -L-
to Sta. 15+00 -L-
Refer To E. C. Special Provisions
for Special Considerations.

GRAPHIC SCALE

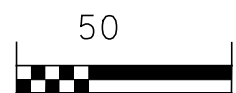

PLANS

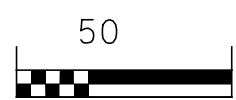

PROFILE (HORIZONTAL)



PROFILE (VERTICAL)

THESE EROSION AND SEDIMENT
CONTROL PLANS COMPLY WITH
THE REGULATIONS SET FORTH
BY THE NCG-010000 GENERAL
CONSTRUCTION PERMIT EFFECTIVE
AUGUST 1, 2016 AND ISSUED BY
THE NORTH CAROLINA DEPARTMENT
OF ENVIRONMENT AND NATURAL
RESOURCES DIVISION OF WATER
RESOURCES.

Prepared In the Office of:



5121 Kingdom Way,
Suite 100
Raleigh, NC 27607
NC License No: F-0258

Designed by:

STACEY H. BAILEY, PE

NAME

3074

LEVEL III CERTIFICATION NO.

Reviewed In the Office of:

ROADSIDE ENVIRONMENTAL UNIT

1 South Wilmington St.
Raleigh, NC 27611

2012 STANDARD SPECIFICATIONS

Reviewed by:


JEFF WALSTON, PE, CPESC, CPSWQ

Roadway Standard Drawings

The following roadway english standards as appear in "Roadway Standard Drawings"- Roadway Design Unit - N. C. Department of Transportation - Raleigh, N. C., dated January 2012 and the latest revision thereto are applicable to this project and by reference hereby are considered a part of these plans.

1604.01	Railroad Erosion Control Detail	1632.01	Rock Inlet Sediment Trap Type A
1605.01	Temporary Silt Fence	1632.02	Rock Inlet Sediment Trap Type B
1606.01	Special Sediment Control Fence	1632.03	Rock Inlet Sediment Trap Type C
1607.01	Gravel Construction Entrance	1633.01	Temporary Rock Silt Check Type A
1622.01	Temporary Berms and Slope Drains	1633.02	Temporary Rock Silt Check Type B
1630.01	Riser Basin	1634.01	Temporary Rock Sediment Dam Type A
1630.02	Silt Basin Type B	1634.02	Temporary Rock Sediment Dam Type B
1630.03	Temporary Silt Ditch	1635.01	Rock Pipe Inlet Sediment Trap Type A
1630.04	Stilling Basin	1635.02	Rock Pipe Inlet Sediment Trap Type B
1630.05	Temporary Diversion	1640.01	Coir Fiber Baffle
1630.06	Special Stilling Basin	1645.01	Temporary Stream Crossing
1631.01	Matting Installation		

TEMPORARY ROCK SILT CHECK TYPE 'A' WITH EXCELSIOR MATTING AND POLYACRYLAMIDE (PAM)

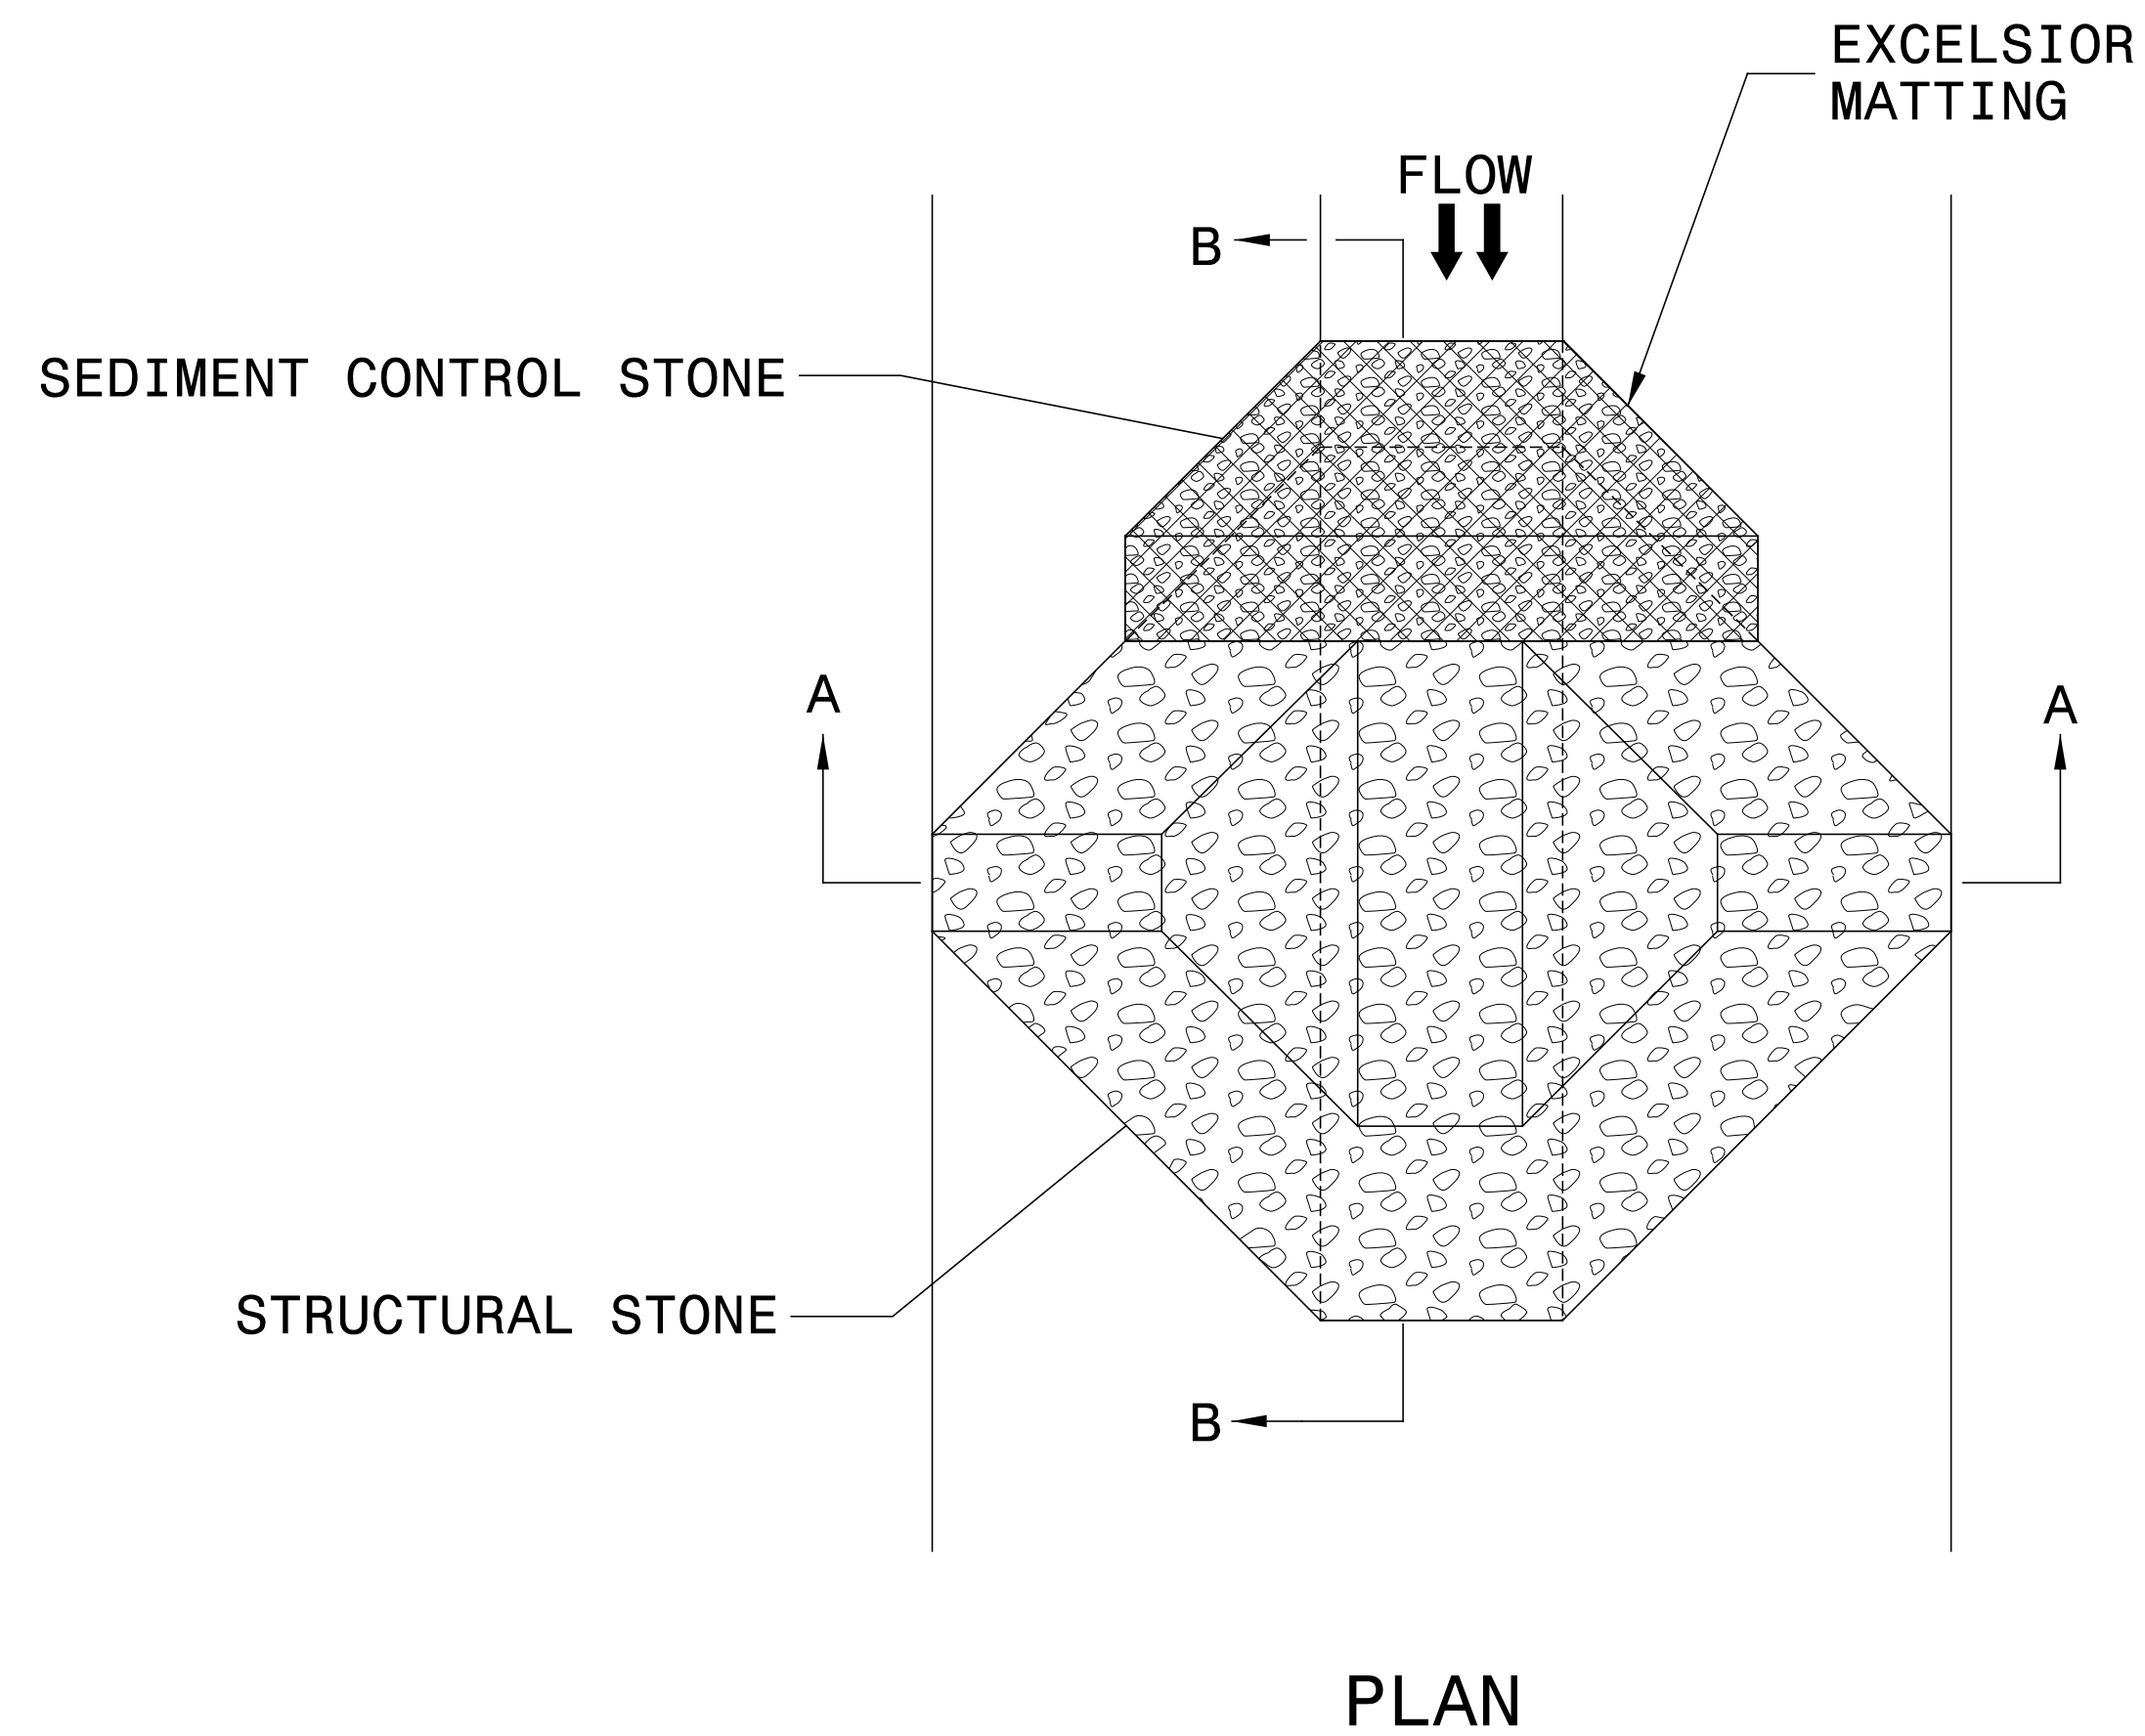




NOTES:

INSTALL TEMPORARY ROCK SILT CHECK TYPE A IN ACCORDANCE WITH ROADWAY STANDARD DRAWING NO. 1633.01.

USE EXCELSIOR FOR MATTING MATERIAL AND ANCHOR MATTING SECTION AT TOP AND BOTTOM WITH CLASS B STONE.

PRIOR TO POLYACRYLAMIDE (PAM) APPLICATION, OBTAIN A SOIL SAMPLE FROM PROJECT LOCATION, AND FROM OFFSITE MATERIAL, AND ANALYZE FOR APPROPRIATE PAM FLOCCULANT TO BE APPLIED TO EACH ROCK SILT CHECK.

INITIALLY APPLY 4 OUNCES OF POLYACRYLAMIDE (PAM) TO TOP OF MATTING SECTION AND AFTER EVERY RAINFALL EVENT THAT EQUALS OR EXCEEDS 0.50 INCHES.

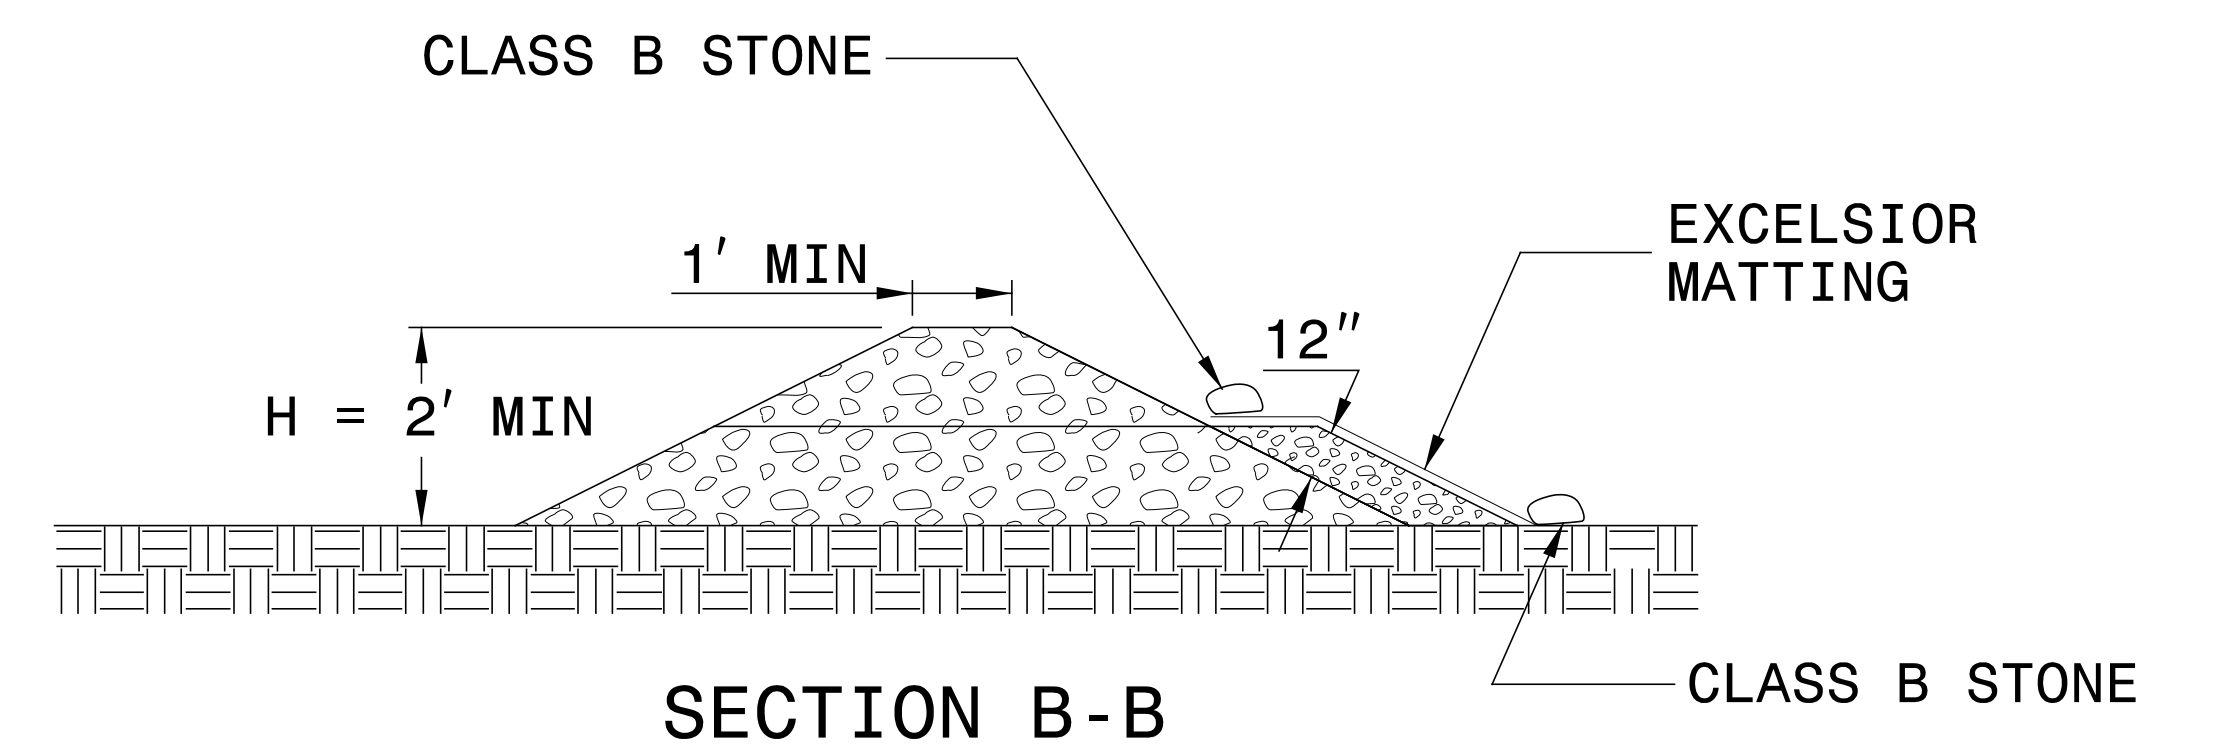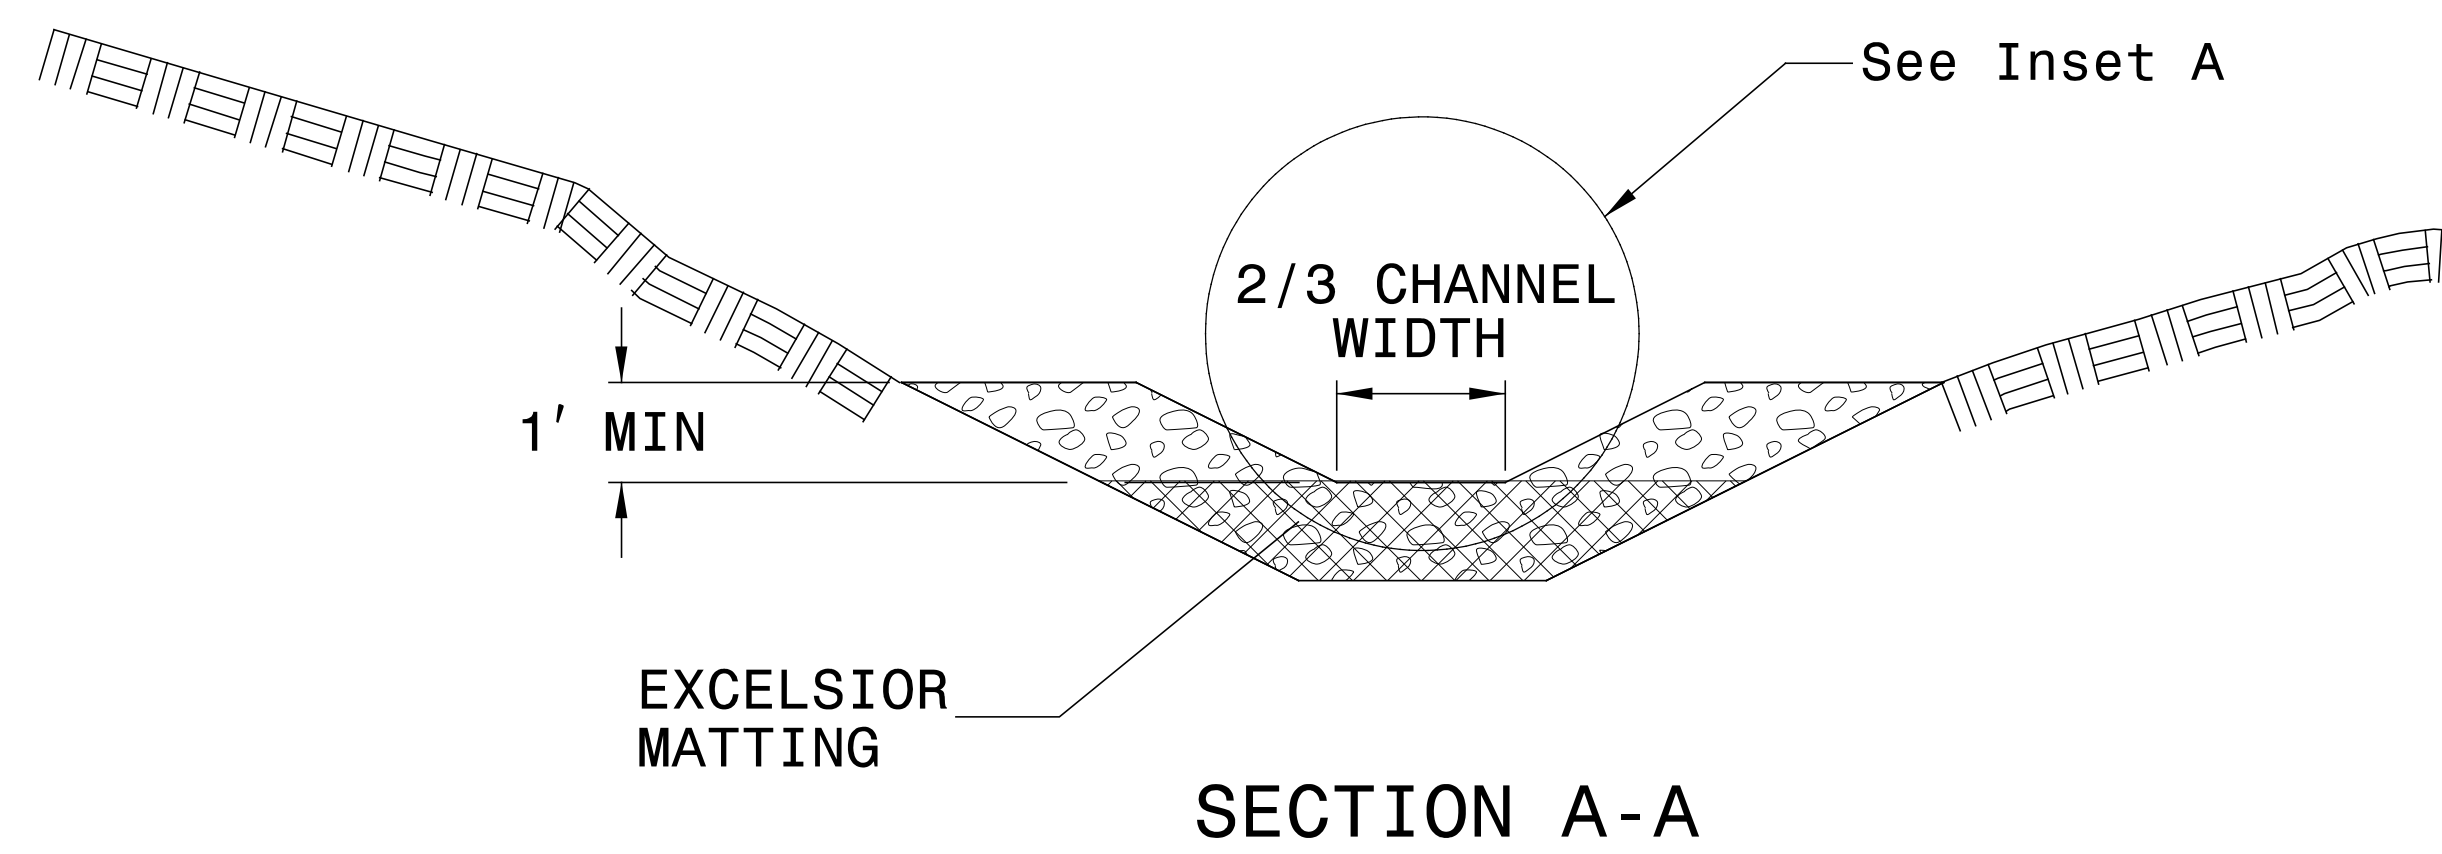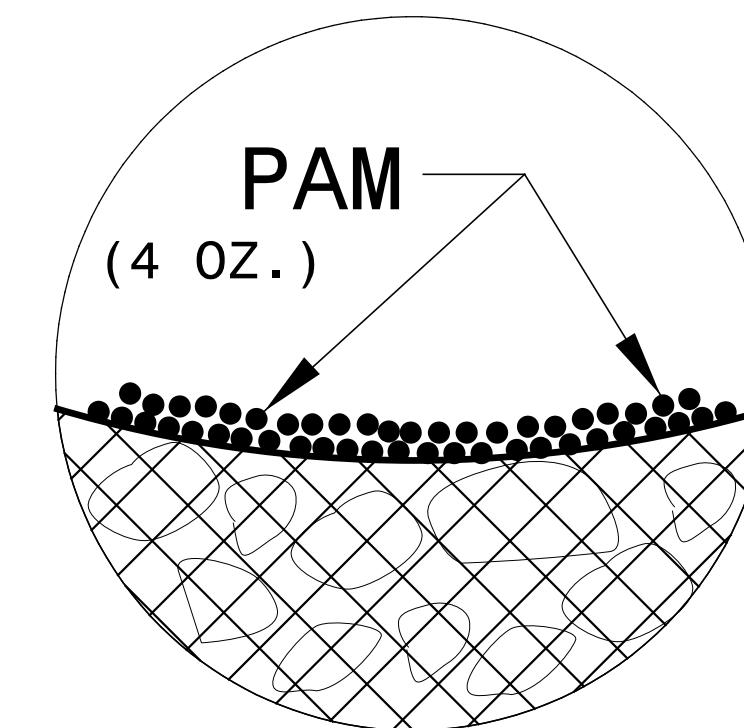

NOT TO SCALE

DIVISION OF HIGHWAYS
STATE OF NORTH CAROLINA




SOIL STABILIZATION TIMEFRAMES

SITE DESCRIPTION	STABILIZATION TIME	TIMEFRAME EXCEPTIONS
PERIMETER DIKES, SWALES, DITCHES AND SLOPES	7 DAYS	NONE
HIGH QUALITY WATER (HQW) ZONES	7 DAYS	NONE
SLOPES STEEPER THAN 3:1	7 DAYS	IF SLOPES ARE 10’ OR LESS IN LENGTH AND ARE NOT STEEPER THAN 2:1, 14 DAYS ARE ALLOWED.
SLOPES 3:1 OR FLATTER	14 DAYS	7 DAYS FOR SLOPES GREATER THAN 50’ IN LENGTH.
ALL OTHER AREAS WITH SLOPES FLATTER THAN 4:1	14 DAYS	NONE, EXCEPT FOR PERIMETERS AND HQW ZONES.


LEVEL III CERTIFIED BY:
STACEY H. BAILEY, PE
CERTIFICATION NUMBER: 3074
ISSUED: DECEMBER 05, 2016



CLEARING AND GRUBBING
EROSION CONTROL FOR
CONSTRUCTION SHEET 04

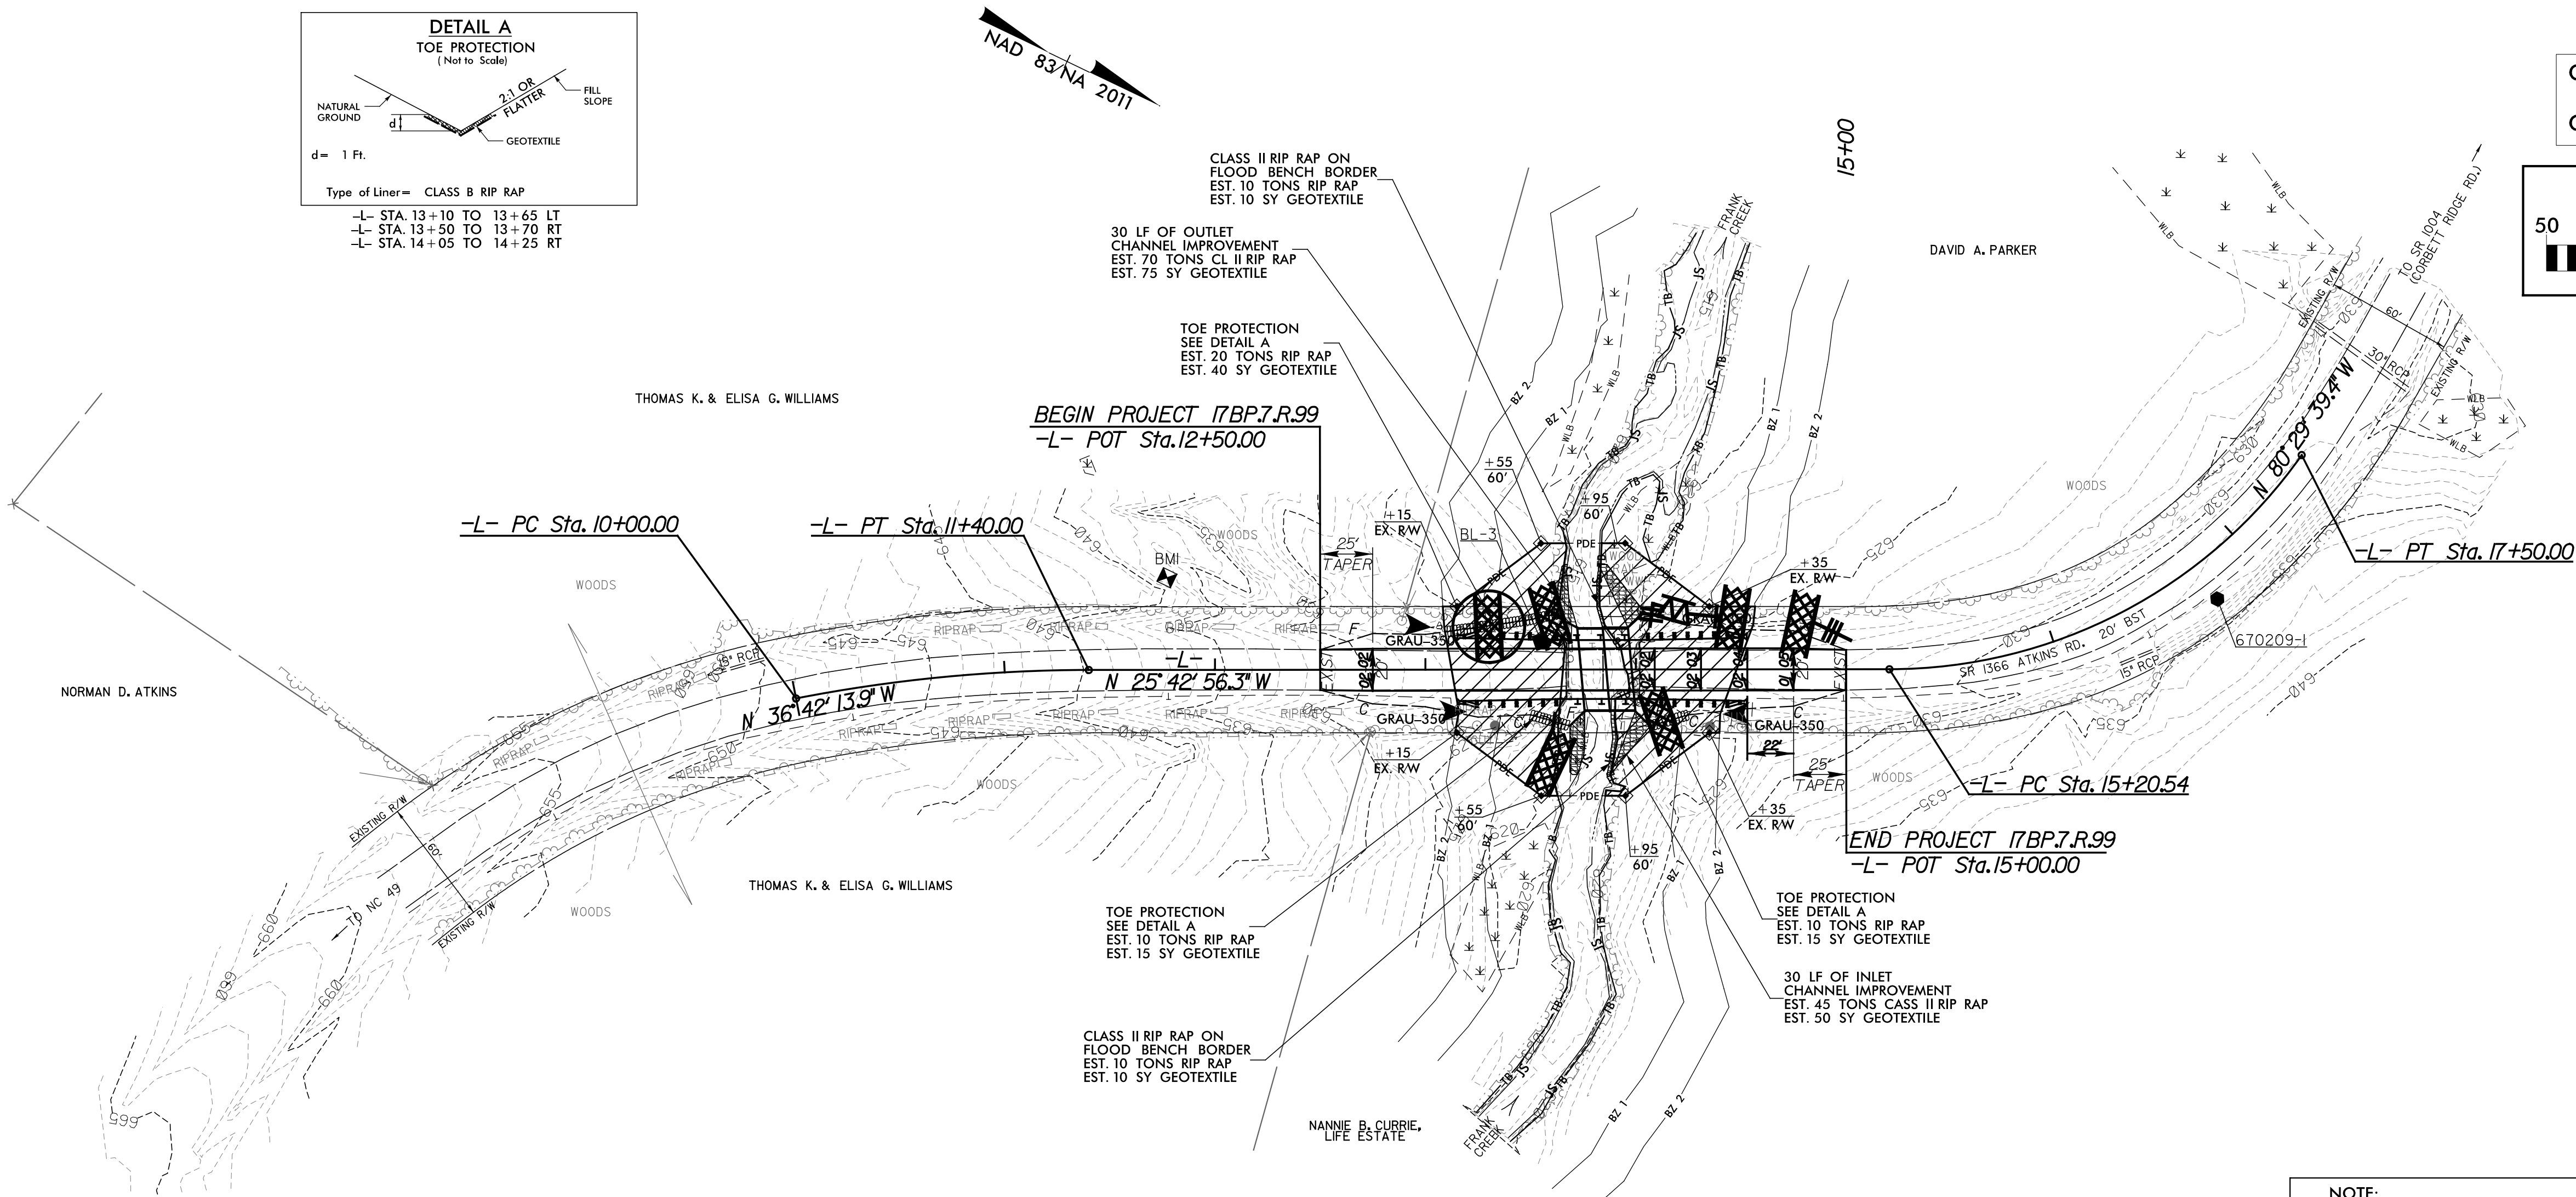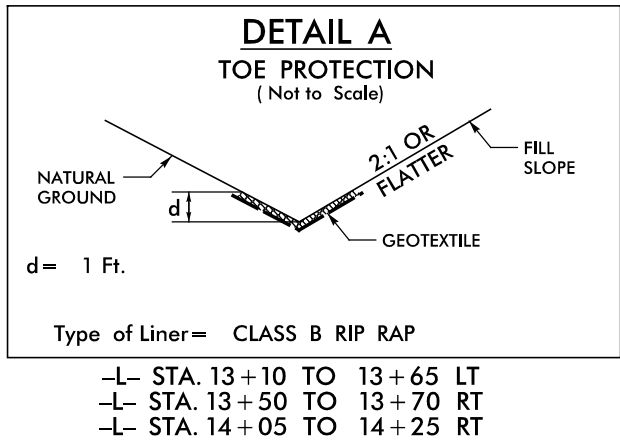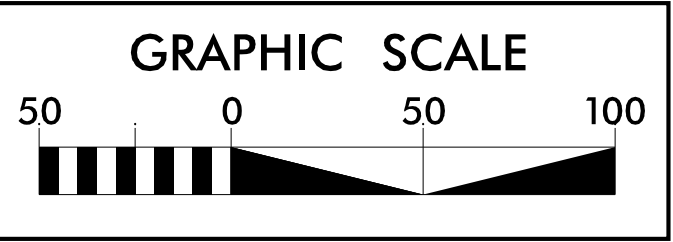


- NOTE:
PLACE TEMPORARY ROCK SEDIMENT DAMS TYPE - B
AND TEMPORARY ROCK SILT CHECKS TYPE - A AT
DRAINAGE OUTLETS.
- NOTE:
PERIMETER EROSION CONTROL MEASURES SHALL BE
INSTALLED DURING CLEARING AND GRUBBING PHASE.
- NOTE:
ALL EROSION CONTROL DEVICES SHOWN ARE
LOCATED WITHIN EXISTING R/W OR EASEMENT.

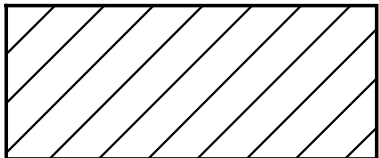


ENVIRONMENTALLY SENSITIVE AREA
SEE PROJECT SPECIAL PROVISIONS

5/14/99
2/21/2017
C:\Users\erossion\Control\cadd\670209_hyd.ec.construction_sequence.dgn
17BP.7.R.99
EC-4A/CONST.4
BRIDGE NO. 209 OVER FRANK CREEK ON SR 1366 (ATKINS ROAD) ORANGE COUNTY, NC

CONSTRUCTION SEQUENCE

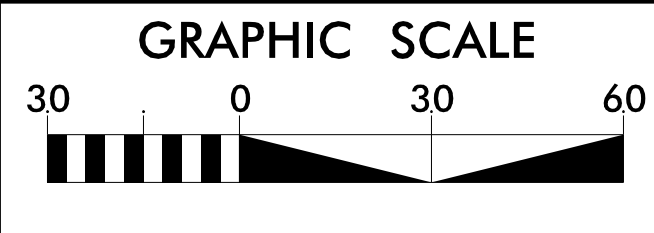

PROJECT REFERENCE NO.	SHEET NO.
17BP.7.R.99	EC-4A/CONST.4
RW SHEET NO.	
BRIDGE NO. 209 OVER FRANK CREEK ON SR 1366 (ATKINS ROAD) ORANGE COUNTY, NC	

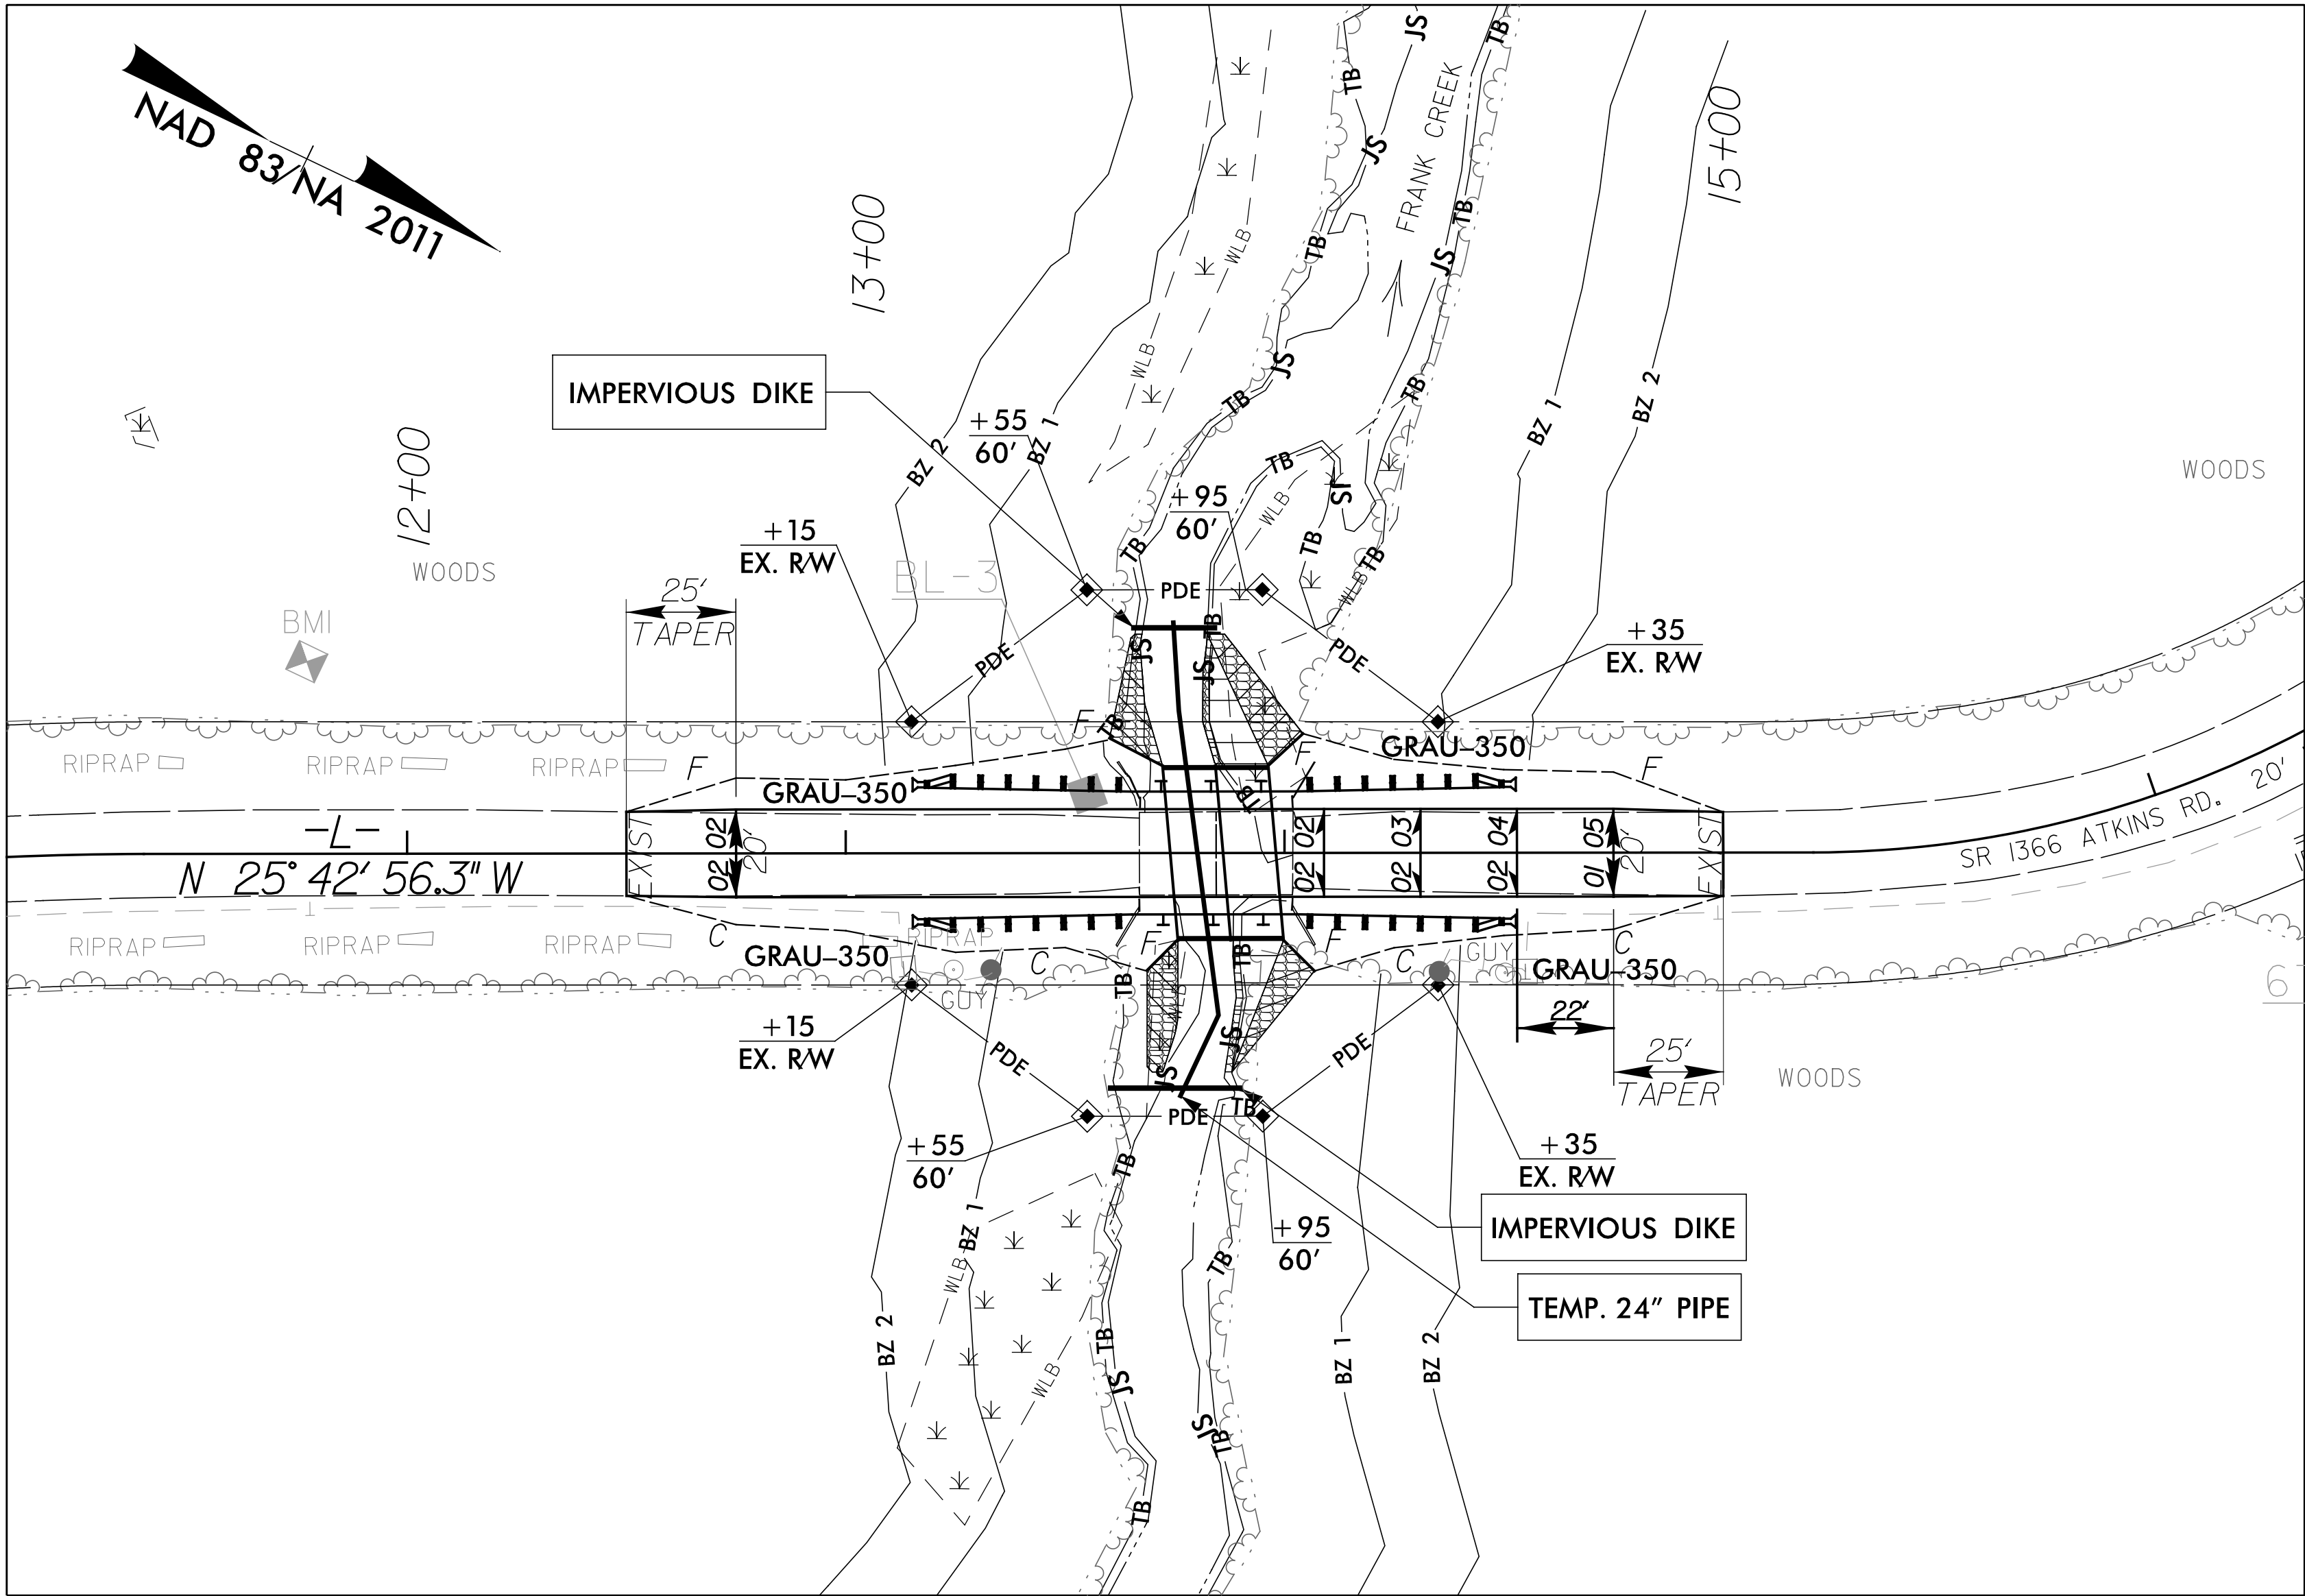

CULVERT PHASING SF-670209

PHASE 1

- 1.) INSTALL ALL TEMPORARY SEDIMENT CONTROL DEVICES NECESSARY FOR CULVERT CONSTRUCTION.
- 2.) INSTALL SPECIAL STILLING BASIN WITHIN PROJECT RIGHT-OF-WAY. PUMP ALL EFFLUENT INTO SPECIAL STILLING BASIN.
- 3.) INSTALL IMPERVIOUS DIKES AND INSTALL 24" TEMP. PIPE.
- 4.) DE-WATER EFFLUENT FROM WORK SITE INTO SPECIAL STILLING BASIN.
- 5.) CONSTRUCT PROPOSED 2 @ 12' X 7' RCBC, CHANNEL IMPROVEMENTS AND FLOOD BENCH PER PLANS.


PHASE 2

- 6.) REMOVE TEMPORARY IMPERVIOUS DIKES AND TEMPORARY PIPE TO ALLOW FLOW THROUGH NEWLY CONSTRUCTED CULVERT.
- 7.) UPON STABILIZATION OF ALL DISTRUBED AREAS, REMOVE ALL TEMPORARY SEDIMENT CONTROL DEVICES.


PLANTING DETAILS
SEEDLING / LINER BAREROOT PLANTING DETAIL

HEALING IN


1. Locate a healing-in site in a shady, well protected area.
2. Excavate a flat bottom trench 12 inches deep and provide drainage.

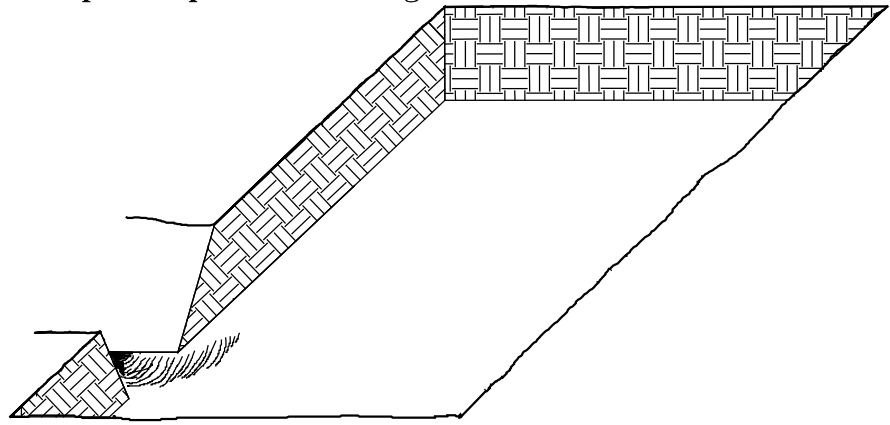


3. Backfill the trench with 2 inches well rotted sawdust. Place a 2 inch layer of well rotted sawdust at a sloping angle at one end of the trench.

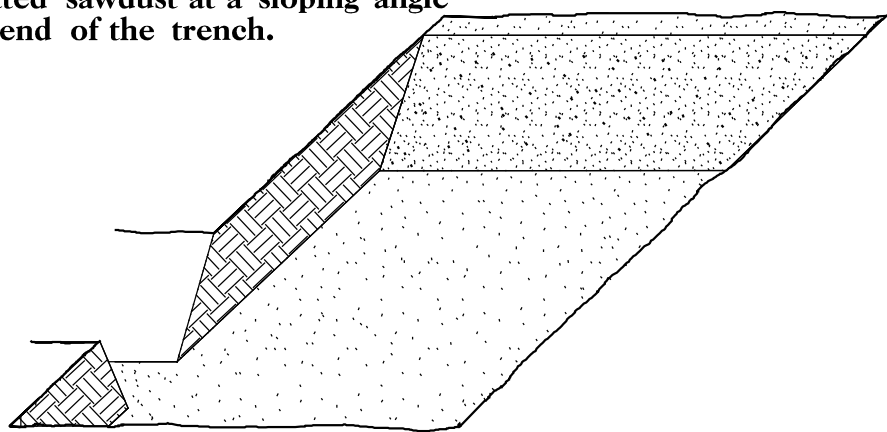

4. Place a single layer of plants against the sloping end so that the root collar is at ground level.

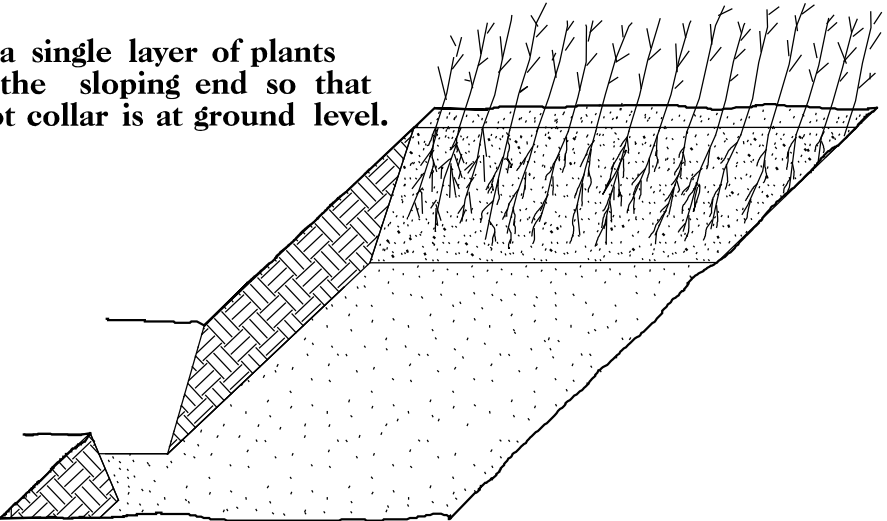


5. Place a 2 inch layer of well rotted sawdust over the roots maintaining a sloping angle.

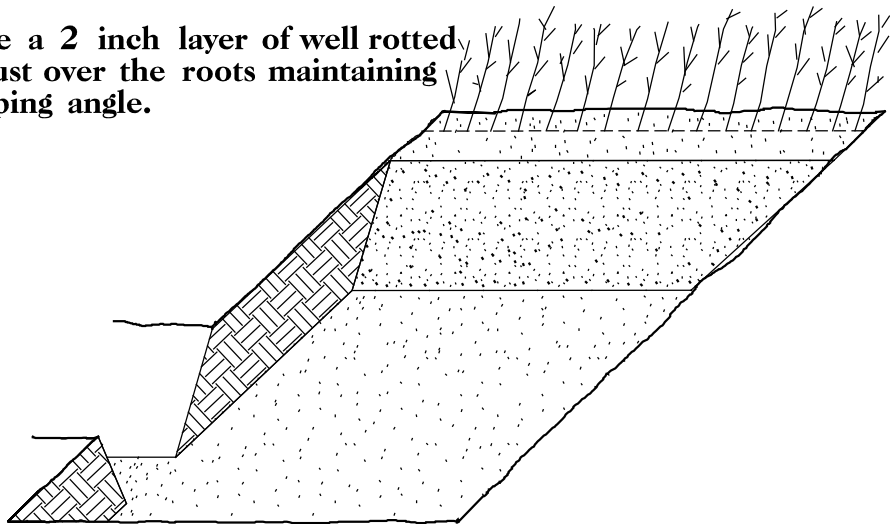


6. Repeat layers of plants and sawdust as necessary and water thoroughly.


DIBBLE PLANTING METHOD
USING THE KBC PLANTING BAR

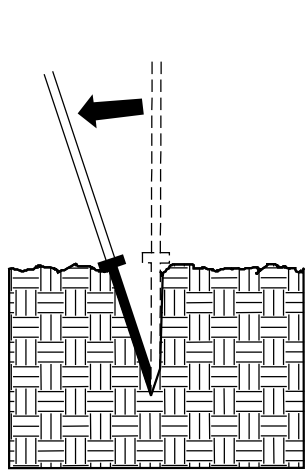


1. Insert planting bar as shown and pull handle toward planter.

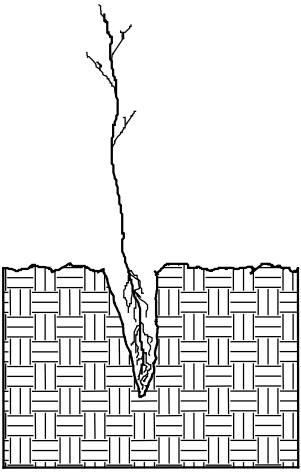


2. Remove planting bar and place seedling at correct depth.

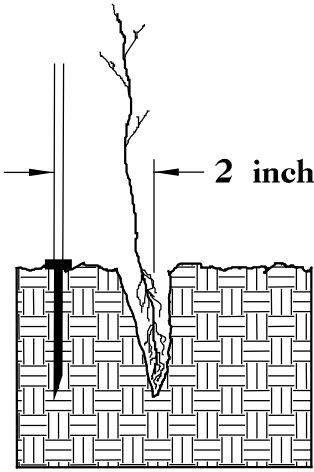


3. Insert planting bar 2 inches toward planter from seedling.

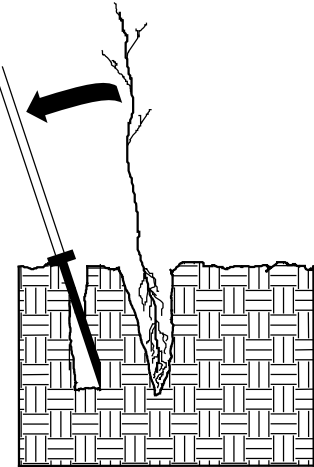

4. Pull handle of bar toward planter, firming soil at bottom.

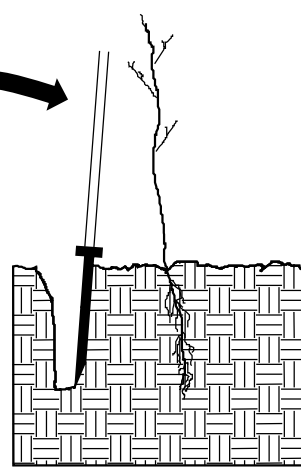


5. Push handle forward firming soil at top.

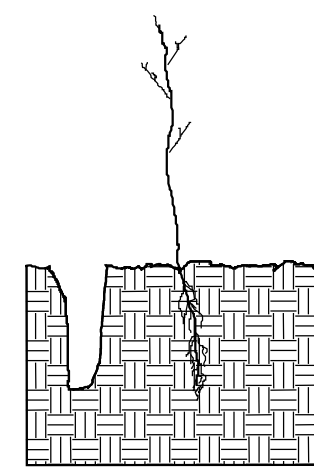


6. Leave compaction hole open. Water thoroughly.

PLANTING NOTES:

PLANTING BAG
During planting, seedlings shall be kept in a moist canvas bag or similar container to prevent the root systems from drying.

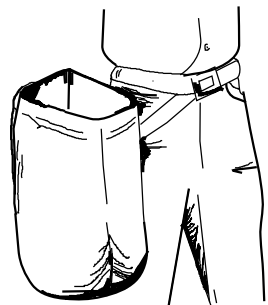

KBC PLANTING BAR
Planting bar shall have a blade with a triangular cross section, and shall be 12 inches long, 4 inches wide and 1 inch thick at center.

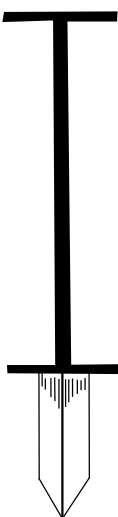

ROOT PRUNING
All seedlings shall be root pruned, if necessary, so that no roots extend more than 10 inches below the root collar.

REFORESTATION

- ☐ TREE REFORESTATION SHALL BE PLANTED 6 FT. TO 10 FT. ON CENTER, RANDOM SPACING, AVERAGING 8 FT. ON CENTER, APPROXIMATELY 680 PLANTS PER ACRE.

REFORESTATION


MIXTURE, TYPE, SIZE, AND FURNISH SHALL CONFORM TO THE FOLLOWING:

25% LIRIODENDRON TULIPIFERA	TULIP POPLAR	12 in - 18 in BR
25% PLATANUS OCCIDENTALIS	AMERICAN SYCAMORE	12 in - 18 in BR
25% FRAXINUS PENNSYLVANICA	GREEN ASH	12 in - 18 in BR
25% BETULA NIGRA	RIVER BIRCH	12 in - 18 in BR

REFORESTATION DETAIL SHEET


N.C.D.O.T. - ROADSIDE ENVIRONMENTAL UNIT

2/15/2017 2:03:28 PM
F:\R02009\Xsc\Xp1\670209_rdy.xpl.dgn
jor-66165

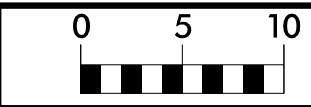


PROJECT REFERENCE
17BP.7.R.99 - ORANGE 209


SHEET NO.
X-2

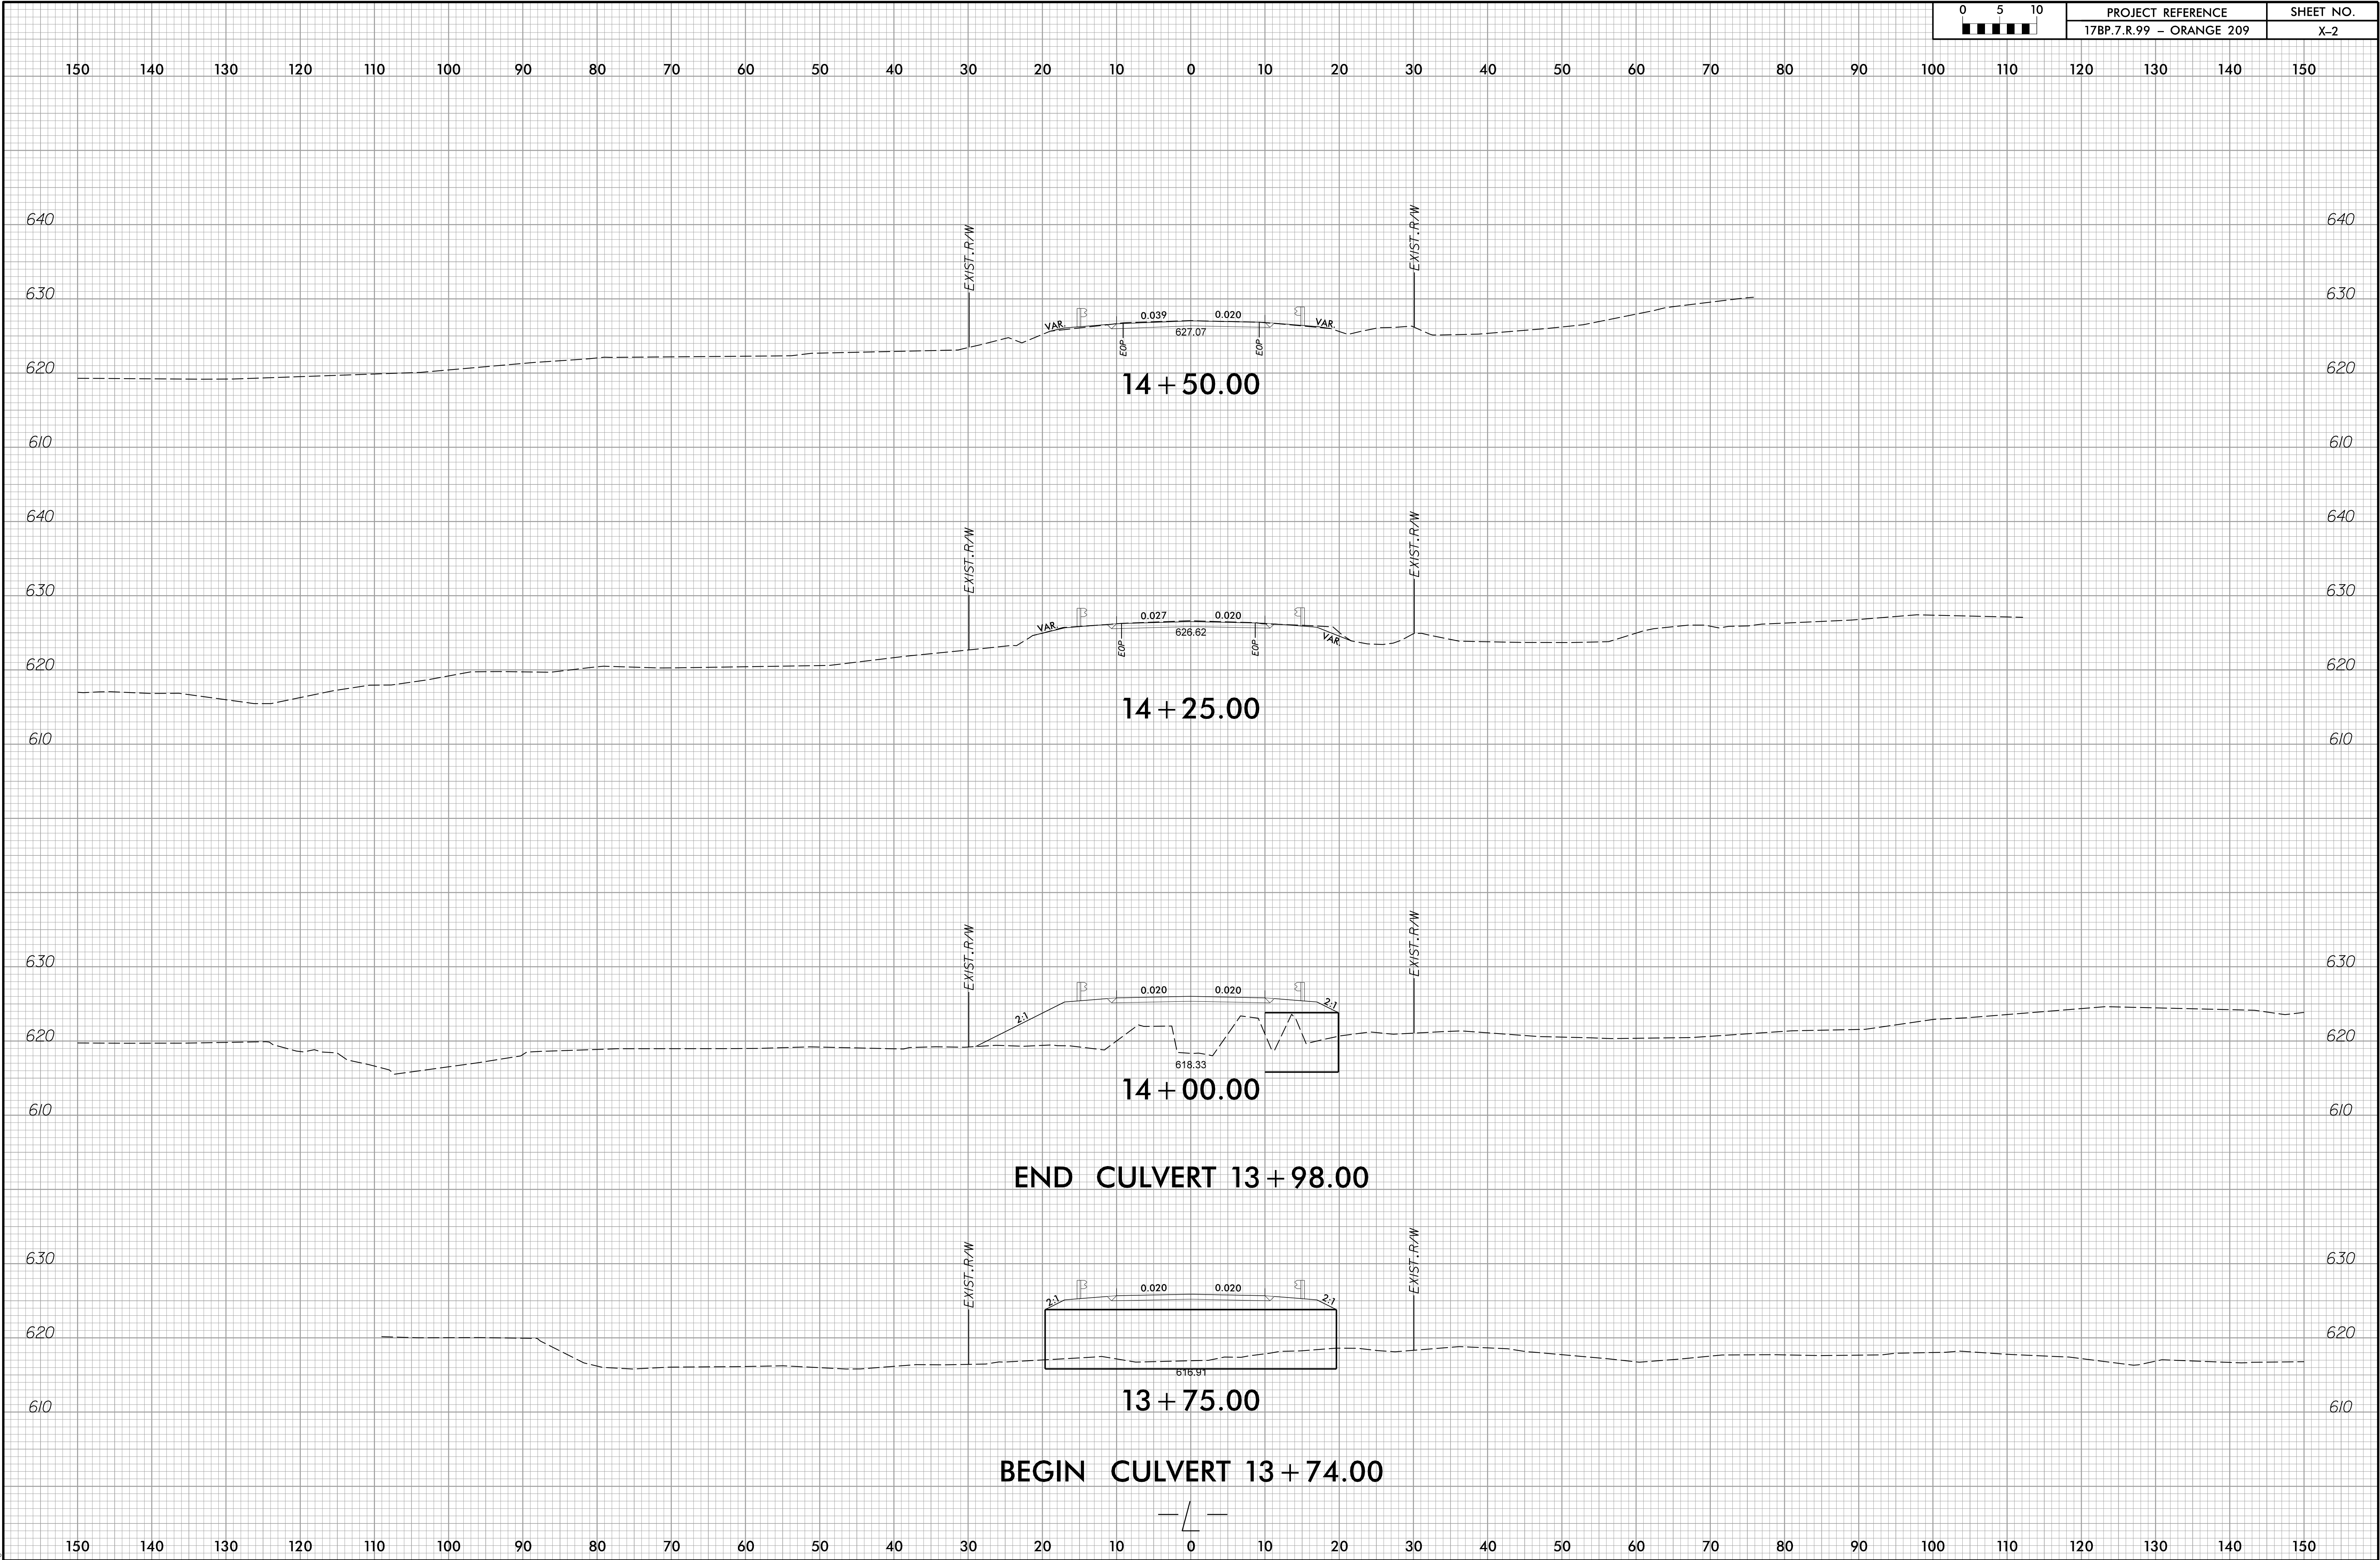


2/15/2017 2:03:28 PM
F:\Roadway\Xsc\Xp1\670209_rdy.xpl.dgn
jor-66165

0 5 10 [Scale Bar]	PROJECT REFERENCE	SHEET NO.
	17BP.7.R.99 – ORANGE 209	X-3

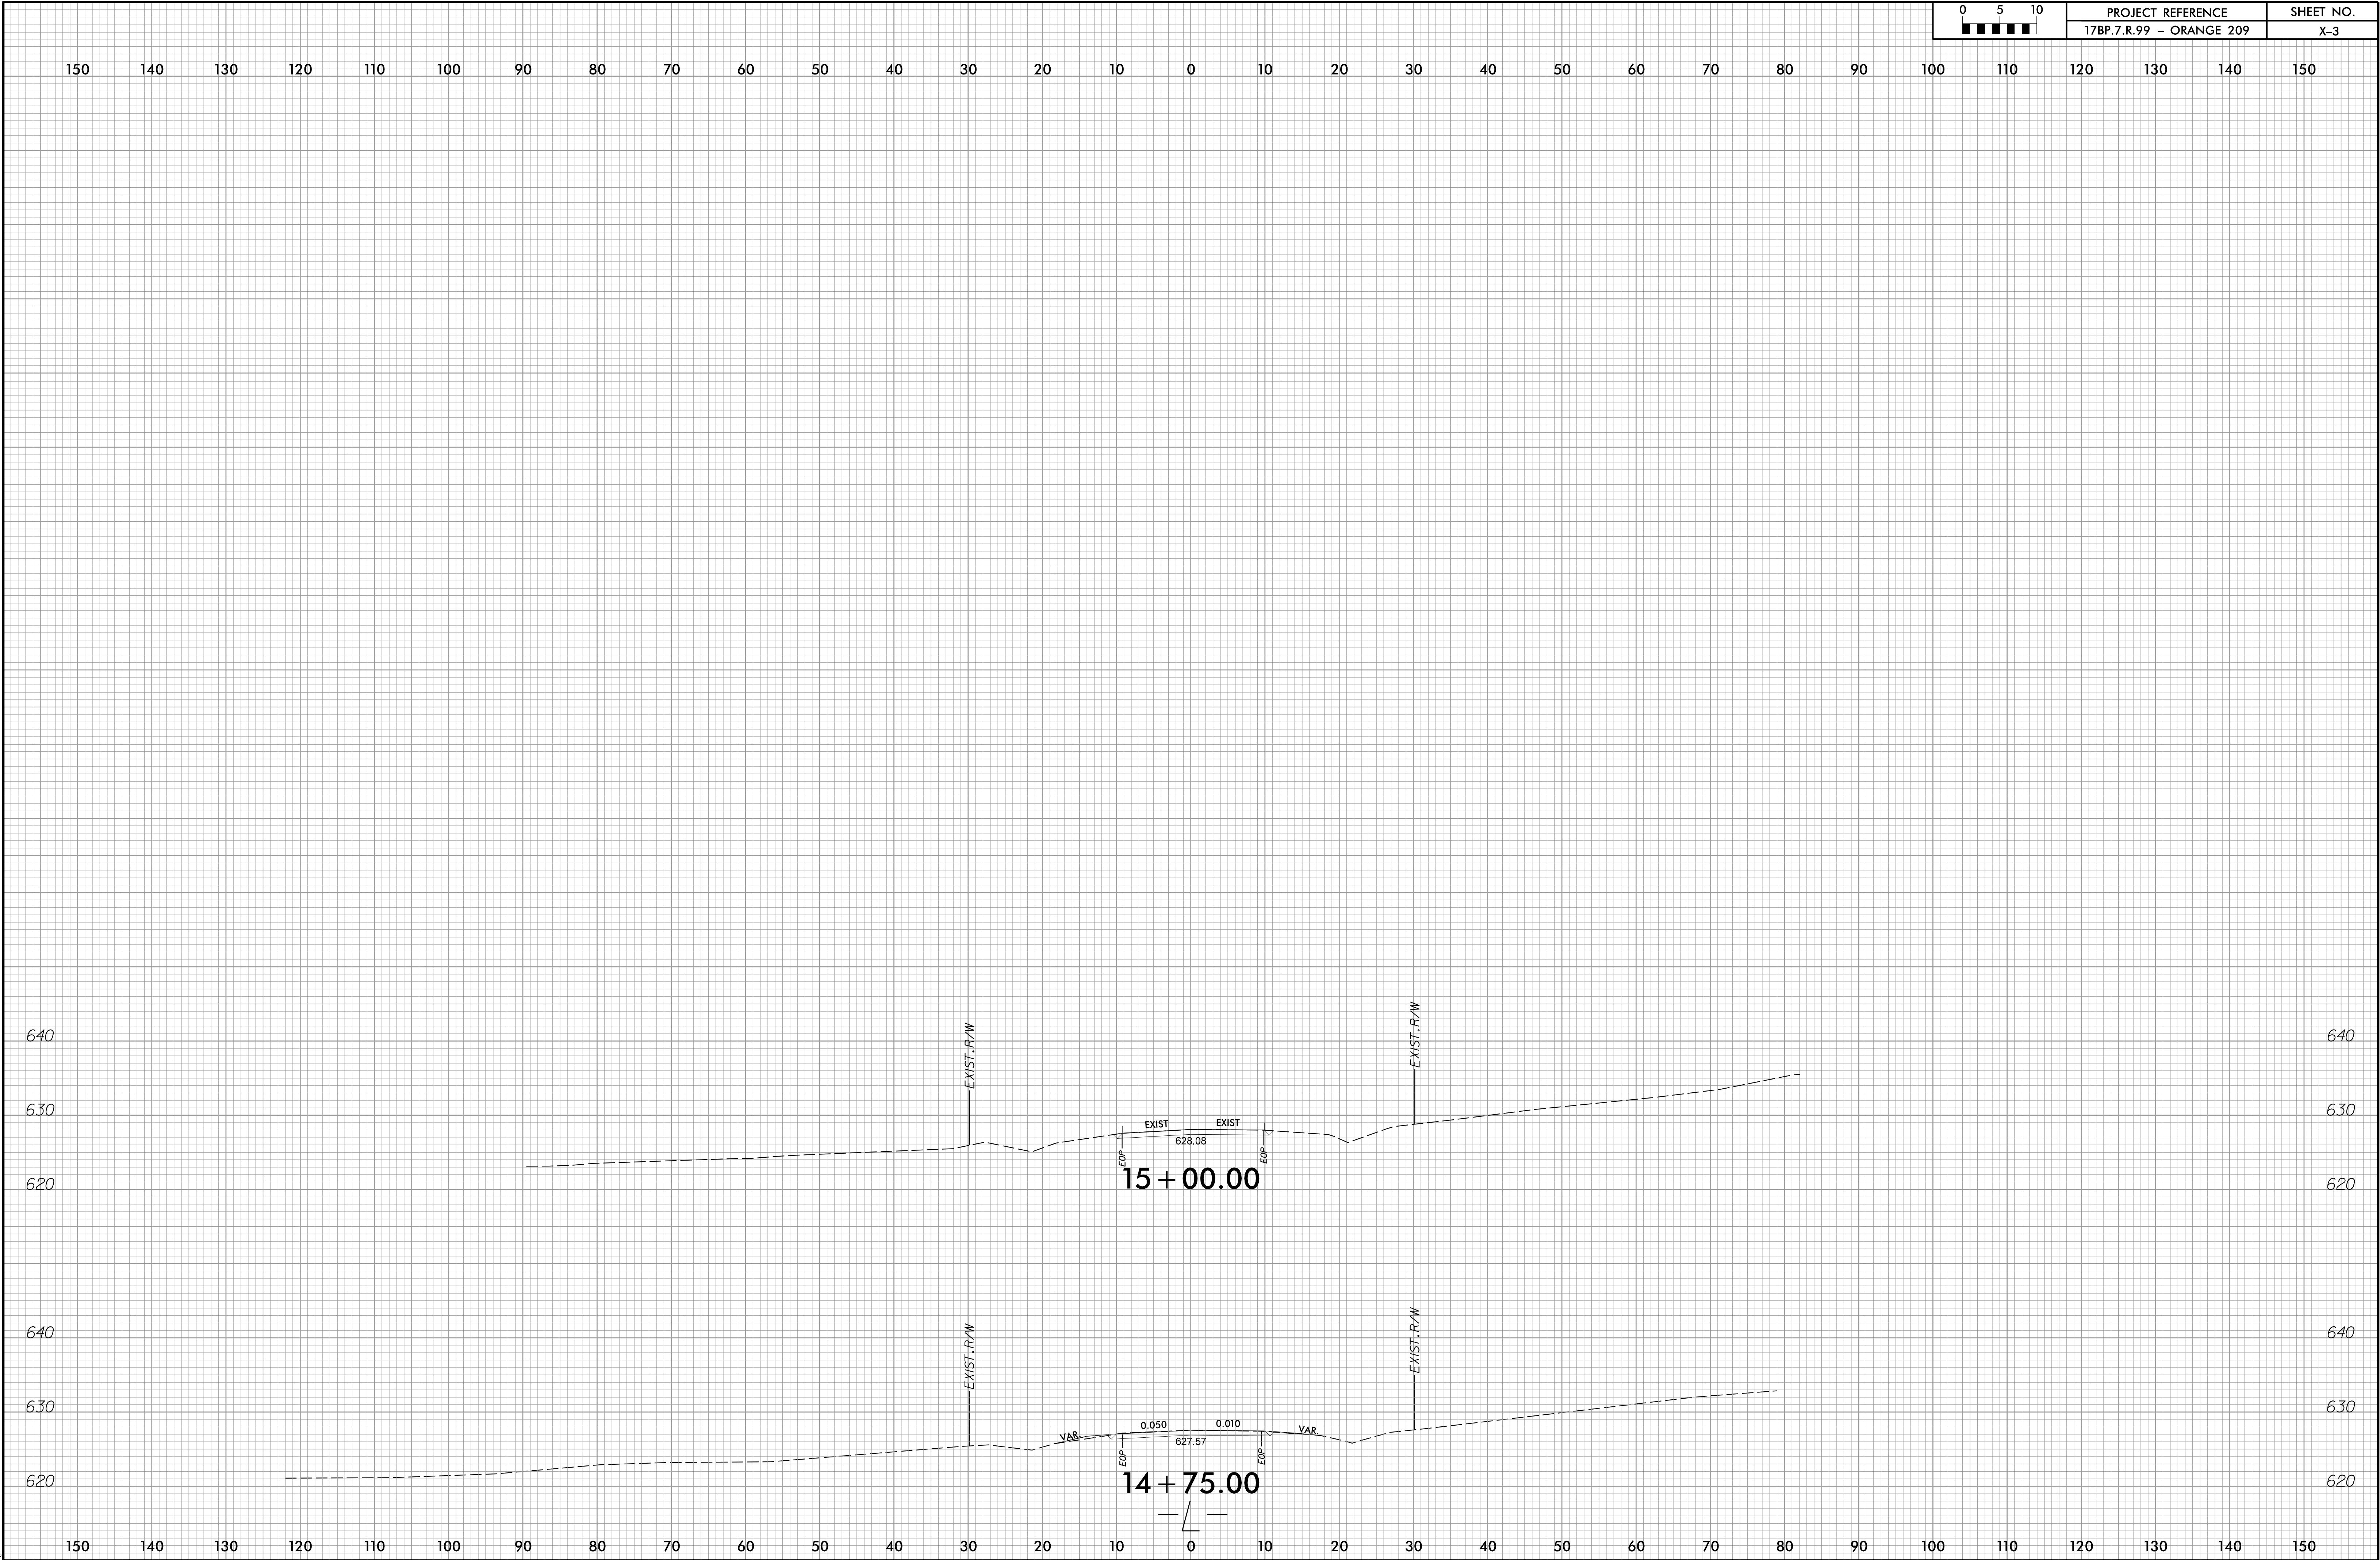

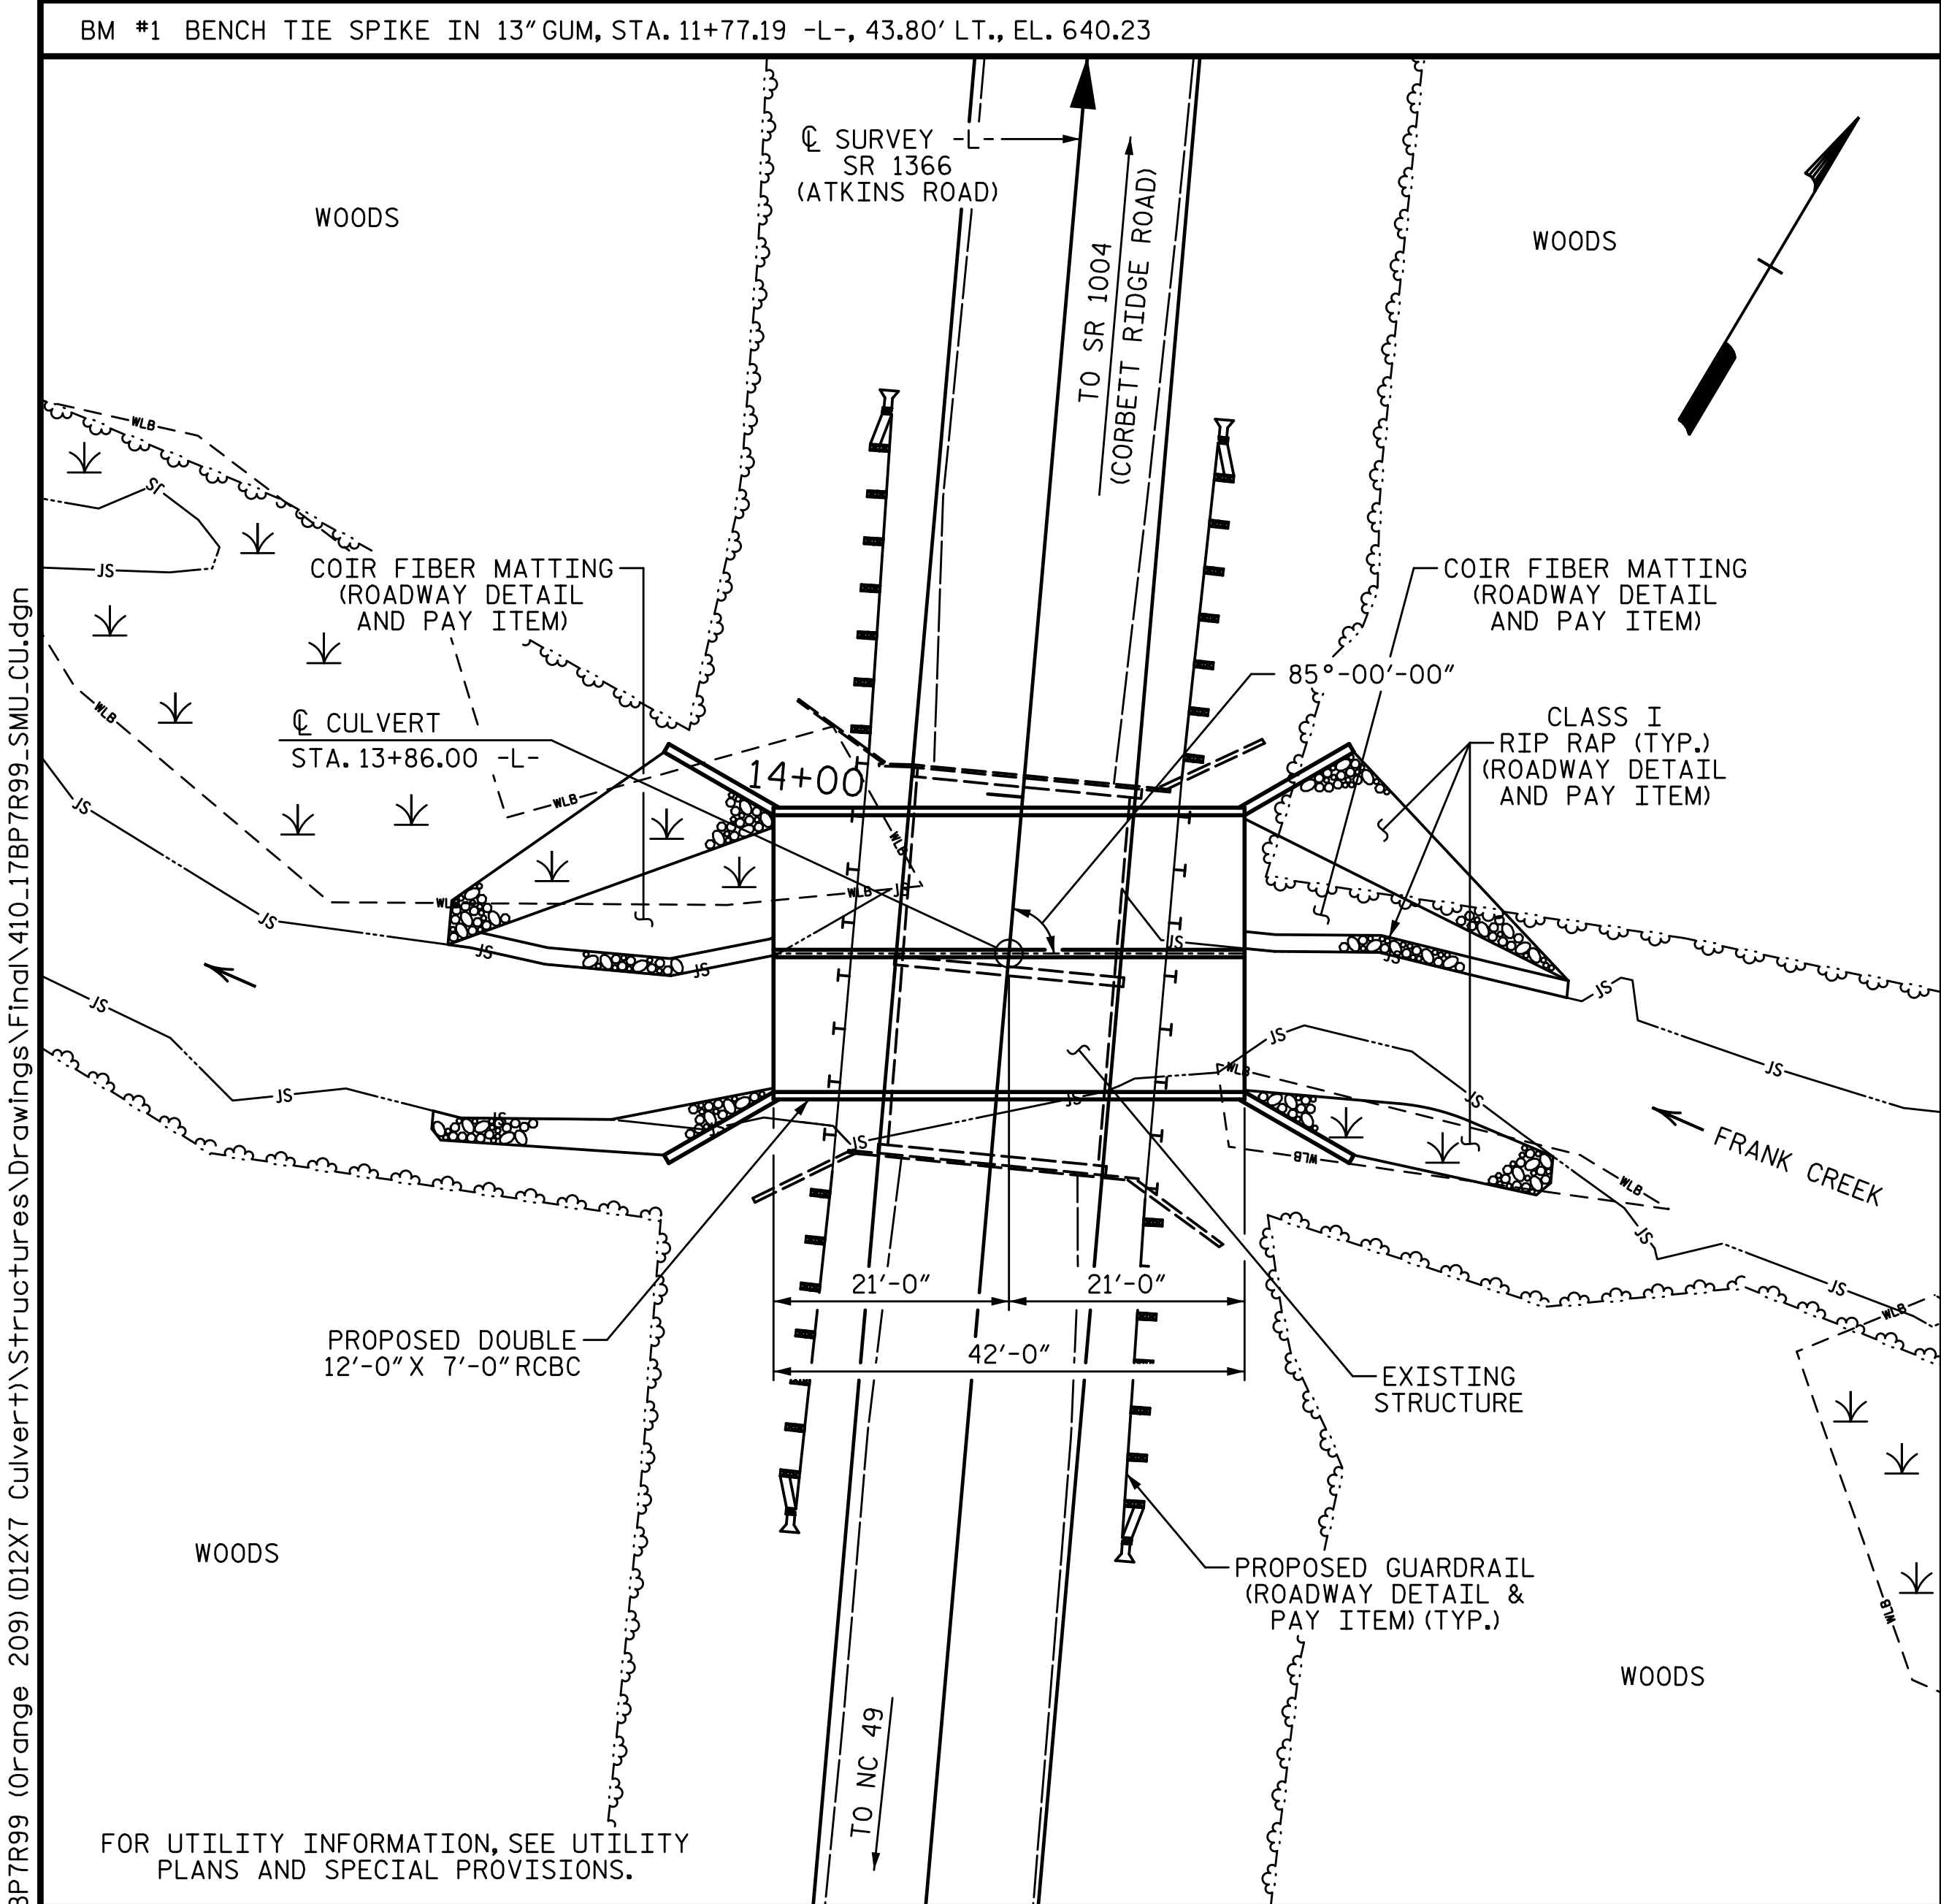

LOCATION SKETCH

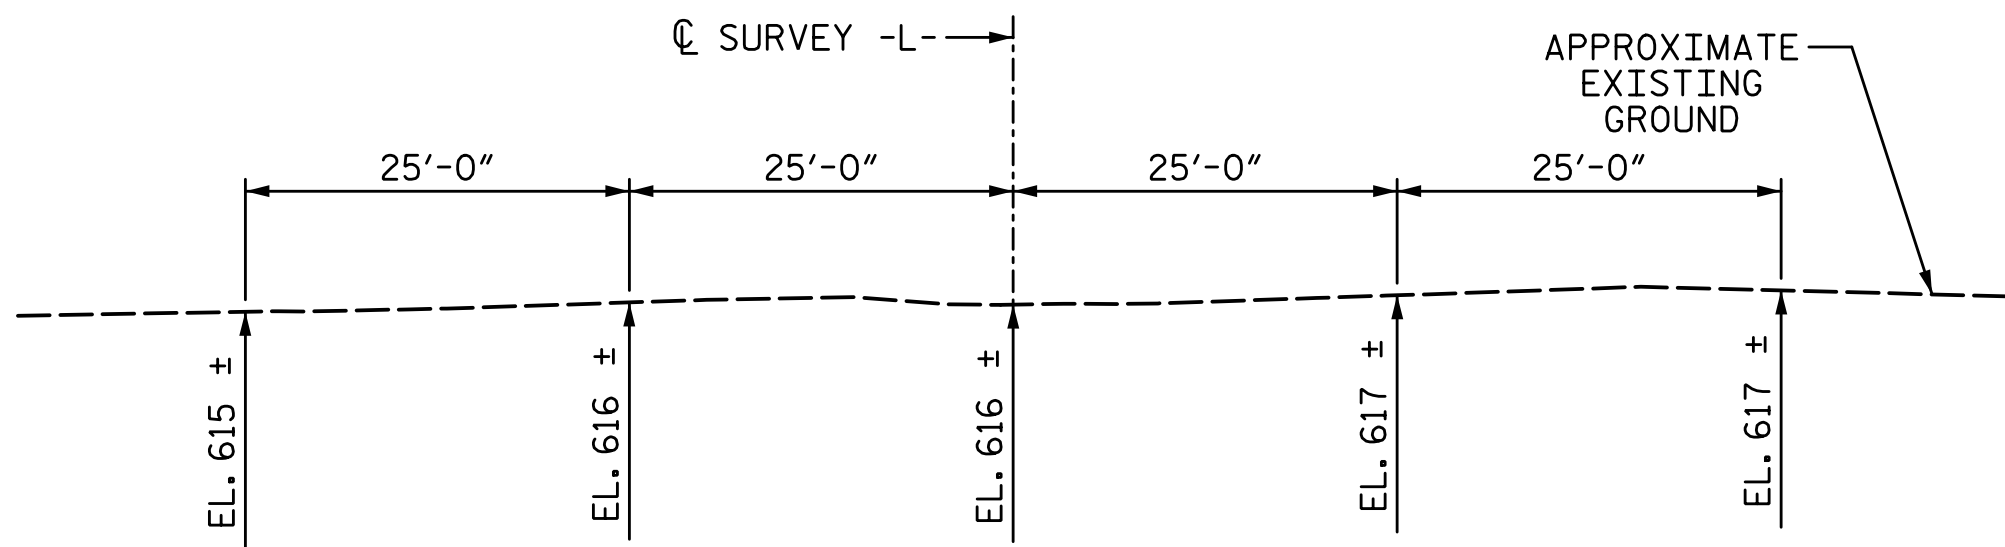

PROFILE ALONG CULVERT

HYDRAULIC DATA:

DESIGN DISCHARGE = 800 CFS
FREQUENCY OF DESIGN FLOOD = 25 YEAR
DESIGN HIGH WATER ELEVATION = 622.30
DRAINAGE AREA = 2.0 SQ. MI.
BASE DISCHARGE (Q 100) = 1200 CFS
BASE HIGH WATER ELEVATION = 623.47

OVERTOPPING FLOOD DATA:

OVERTOPPING DISCHARGE = 2200 CFS
FREQUENCY OF OVERTOPPING FLOOD = 500+ YEAR
OVERTOPPING FLOOD ELEVATION = 625.90 **
** OVERTOPPING OCCURS AT ROADWAY
SAG AT STA. 13+80.00 -L- AT
ROADWAY CENTERLINE

GRADE DATA:

GRADE POINT EL. @ STA. 13+86.00 -L- = EL. 625.89
BED EL. @ STA. 13+86.00 -L- = EL. 615.44
ROADWAY SLOPE 2:1

TOTAL STRUCTURE QUANTITIES

CLASS A CONCRETE	
BARREL @ 2.693 CY/FT	113.1 C.Y.
HEADWALLS	2.4 C.Y.
SILLS	2.7 C.Y.
WING ETC.	20.0 C.Y.
TOTAL	138.2 C.Y.
REINFORCING STEEL	
BARREL	16,358 LBS.
WINGS ETC.	1,151 LBS.
TOTAL	17,509 LBS.
CULVERT EXCAVATION	LUMP SUM
FOUNDATION CONDITIONING MATERIAL	89 TONS
REMOVAL OF EXISTING STRUCTURE	LUMP SUM
ASBESTOS ASSESSMENT	LUMP SUM

FOUNDATION NOTES:

EXCAVATE A MINIMUM OF 1.0 FT. BELOW BEARING ELEVATION AND REPLACE WITH FOUNDATION CONDITIONING MATERIAL PER SECTION 414 OF THE STANDARD SPECIFICATIONS.

OVEREXCAVATE LOOSE/SOFT MATERIAL IF PRESENT TO SUITABLE BEARING MATERIALS AND REPLACE WITH ADDITIONAL CLASS VI FOUNDATION CONDITIONING MATERIAL. PAYMENT IS INCLUDED IN THE LUMP SUM PRICE FOR CULVERT EXCAVATION.

NOTES:

ASSUMED LIVE LOAD -----HL-93 OR ALTERNATE LOADING.

DESIGN FILL----- 2'-6" (MIN.) AND 3'-9" (MAX.)

FOR OTHER DESIGN DATA AND NOTES SEE STANDARD NOTE SHEET.

3" Ø WEEP HOLES INDICATED TO BE IN ACCORDANCE WITH THE SPECIFICATIONS.

CONCRETE IN CULVERTS TO BE POURED IN THE FOLLOWING ORDER:
1. WING FOOTINGS AND FLOOR SLAB INCLUDING 4" OF ALL VERTICAL WALLS.

2. THE REMAINING PORTIONS OF THE WALLS AND WINGS FULL HEIGHT FOLLOWED BY ROOF SLAB AND HEADWALLS.

THE ENGINEER SHALL CHECK THE LENGTH OF CULVERT BEFORE STAKING IT OUT TO MAKE CERTAIN THAT IT WILL PROPERLY TAKE CARE OF THE FILL.

DIMENSIONS FOR WING LAYOUT AS WELL AS ADDITIONAL REINFORCING STEEL EMBEDDED IN BARREL ARE SHOWN ON WING SHEET.

STEEL IN THE BOTTOM SLAB MAY BE SPliced AT THE PERMITTED CONSTRUCTION JOINT AT THE CONTRACTOR'S OPTION. EXTRA WEIGHT OF STEEL DUE TO THE SPLICES SHALL BE PAID FOR BY THE CONTRACTOR.

AT THE CONTRACTOR'S OPTION, HE MAY SPlice THE VERTICAL REINFORCING STEEL IN THE INTERIOR FACE OF EXTERIOR LOWER WALL AND BOTH FACES OF INTERIOR WALLS ABOVE LOWER WALL CONSTRUCTION JOINT. THE SPlice LENGTH SHALL BE AS PROVIDED IN THE SPlice LENGTH CHART SHOWN ON THE PLANS. EXTRA WEIGHT OF STEEL DUE TO THE SPLICES SHALL BE PAID FOR BY THE CONTRACTOR.

REMOVAL OF THE EXISTING BRIDGE SHALL BE PERFORMED SO AS NOT TO ALLOW DEBRIS TO FALL INTO THE WATER. THE CONTRACTOR SHALL REMOVE THE BRIDGE AND SUBMIT PLANS FOR DEMOLITION IN ACCORDANCE WITH ARTICLE 402-2 OF THE STANDARD SPECIFICATIONS.

THE EXISTING STRUCTURE CONSISTS OF 2 SPANS @ 17'-8" WITH A CLEAR ROADWAY WIDTH OF 19'-1". THE SUPERSTRUCTURE CONSISTS OF A TIMBER DECK ON TIMBER JOIST WITH ASPHALT WEARING SURFACE. END BENT 1 CONSISTS OF TIMBER CAP, PILES, POSTS AND SILLS. INTERIOR BENT 1 AND END BENT 2 CONSIST OF TIMBER CAP ON TIMBER PILES. THE EXISTING STRUCTURE, WHICH IS LOCATED AT THE SITE OF THE PROPOSED STRUCTURE, SHALL BE REMOVED. THE EXISTING BRIDGE IS PRESENTLY POSTED FOR LOAD LIMIT. SHOULD THE STRUCTURAL INTEGRITY OF THE BRIDGE DETERIORATE DURING CONSTRUCTION OF THE PROPOSED BRIDGE, THE LOAD LIMIT MAY BE REDUCED AS NECESSARY DURING THE LIFE OF THE PROJECT.

FOR CULVERT DIVERSION DETAILS AND PAY ITEM, SEE EROSION CONTROL PLANS.

FOR SUBMITTAL OF WORKING DRAWINGS, SEE SPECIAL PROVISIONS.

FOR FALSEWORK AND FORMWORK, SEE SPECIAL PROVISIONS.

FOR CRANE SAFETY, SEE SPECIAL PROVISIONS.


FOR GROUT FOR STRUCTURES, SEE SPECIAL PROVISIONS.

A 3 FOOT STRIP OF FILTER FABRIC SHALL BE ATTACHED TO THE FILL FACE OF THE WING COVERING THE ENTIRE LENGTH OF THE EXPANSION JOINT.

FOR ASBESTOS ASSESSMENT FOR BRIDGE DEMOLITION AND RENOVATION ACTIVITIES, SEE SPECIAL PROVISIONS.

CULVERT MUST BE CAST-IN-PLACE, PRECAST OPTION WILL NOT BE ALLOWED.

I HEREBY CERTIFY THESE PLANS ARE THE AS-BUILT PLANS

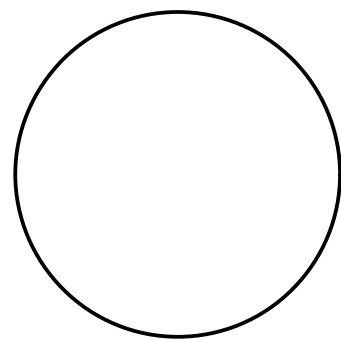

PROJECT NO. 17BP.7.R.99
ORANGE COUNTY
STATION: 13+86.00 -L-

SHEET 1 OF 6 REPLACES BRIDGE #209

STATE OF NORTH CAROLINA
DEPARTMENT OF TRANSPORTATION
RALEIGH

DOUBLE 12 FT. X 7 FT.
CONCRETE BOX CULVERT

85° SKEW

REVISIONS

NO.	BY:	DATE:	NO.	BY:	DATE:	SHEET NO.
1			3			C-1
2			4			TOTAL SHEETS 6

PLANS PREPARED BY:

SLIMPSON ENGINEERS & ASSOCIATES


5640 Dillard Drive
Suite 200
Cary, NC 27518
(919) 852-0468
(919) 852-0598 (Fax)
www.slimpsonengr.com

LICENSURE NO. C-2521

2/15/2017

DOCUMENT NOT CONSIDERED FINAL
UNLESS ALL SIGNATURES COMPLETED


2/15/2017 9:39:13 AM G:\Projects\2015\Division 7 (Hatch Mot)\17BP7R99 (Orange 209) (012X7 Culvert)\Structures\Drawings\Final\410_17BP7R99_SMU_CU.dgn

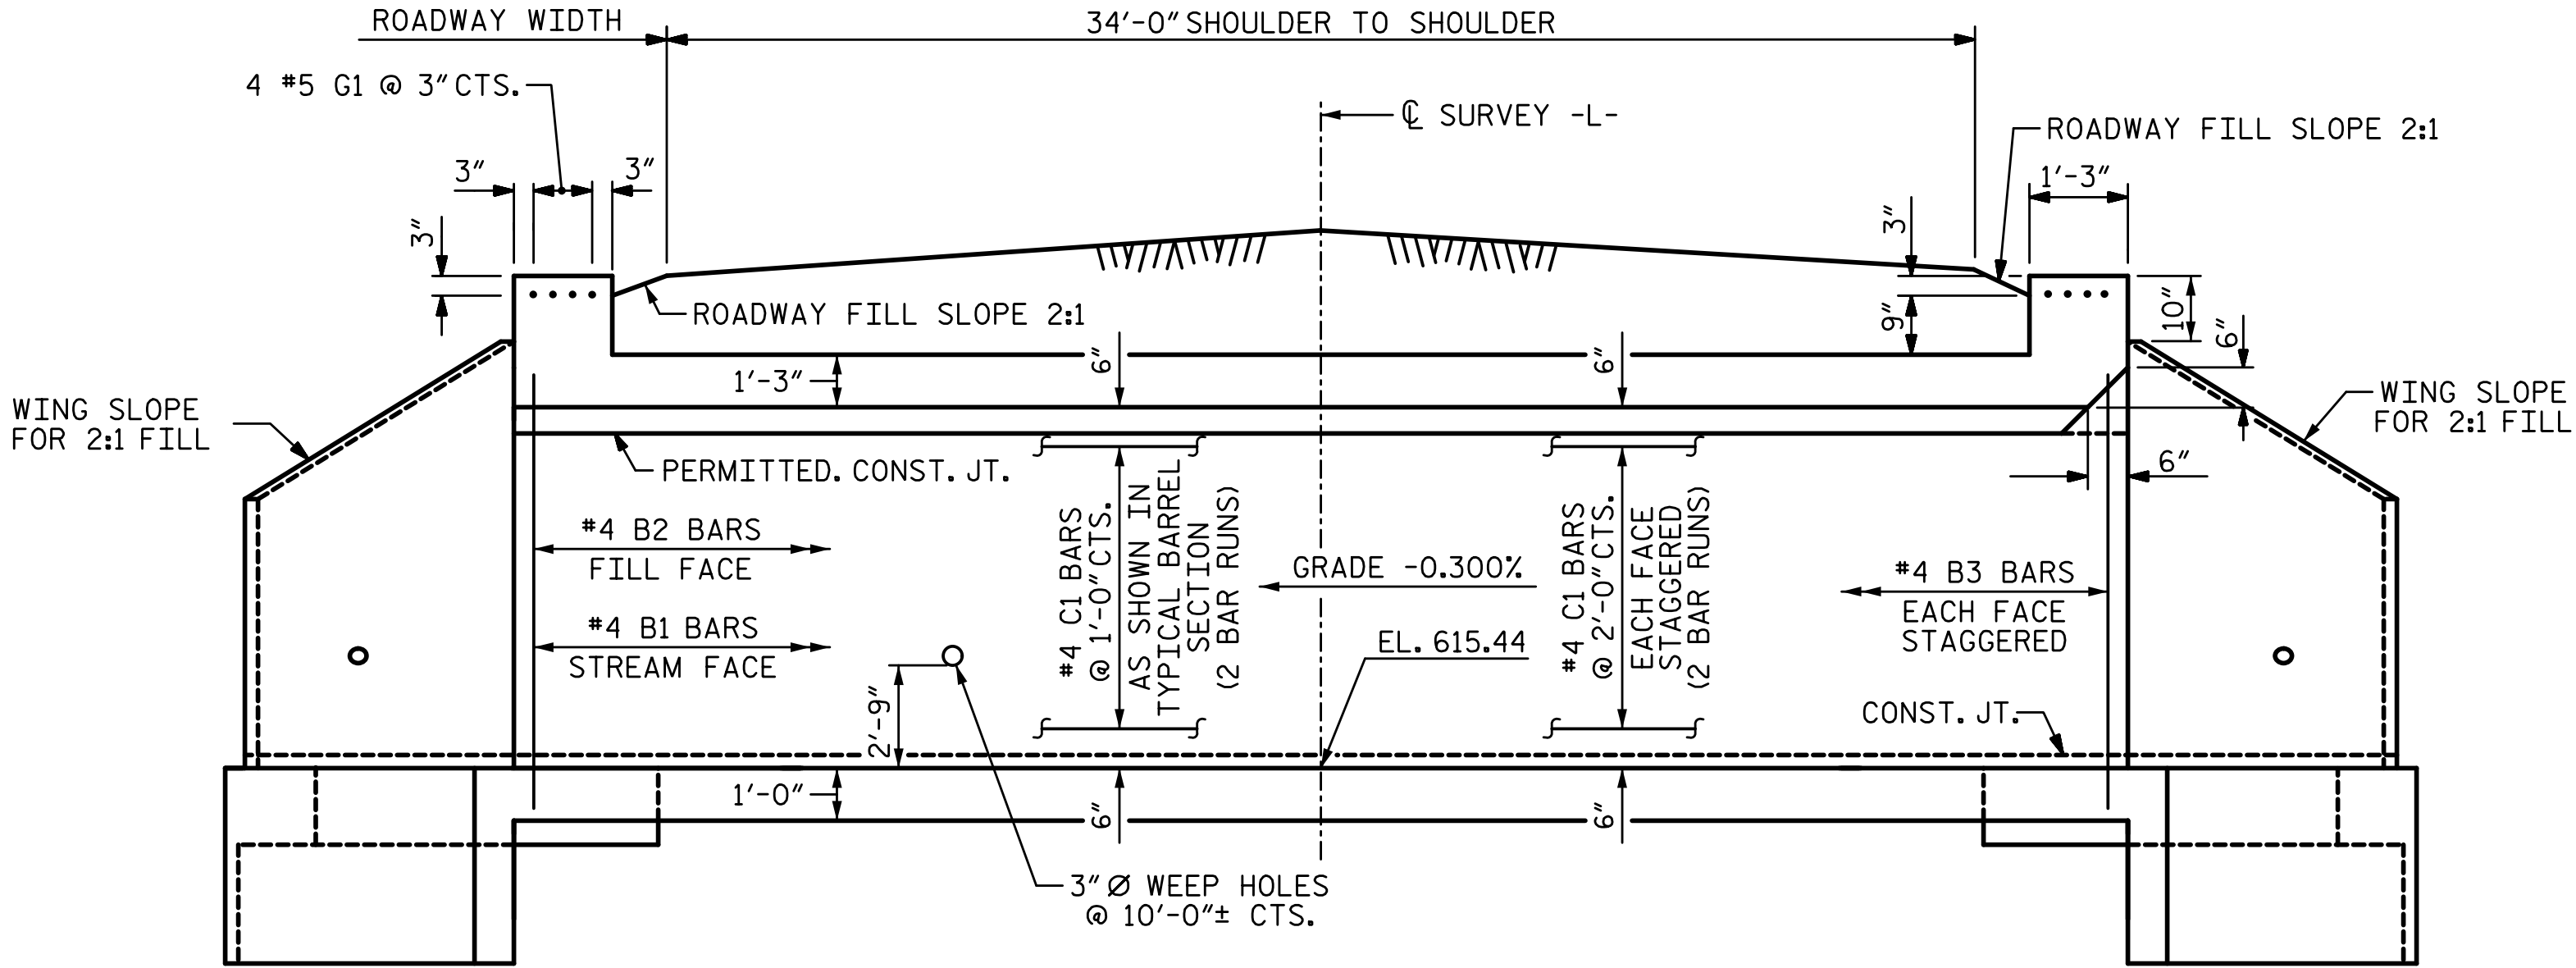

EXTERIOR WALL INTERIOR WALL


CULVERT SECTION NORMAL TO ROADWAY

(CONCRETE SILLS NOT SHOWN)

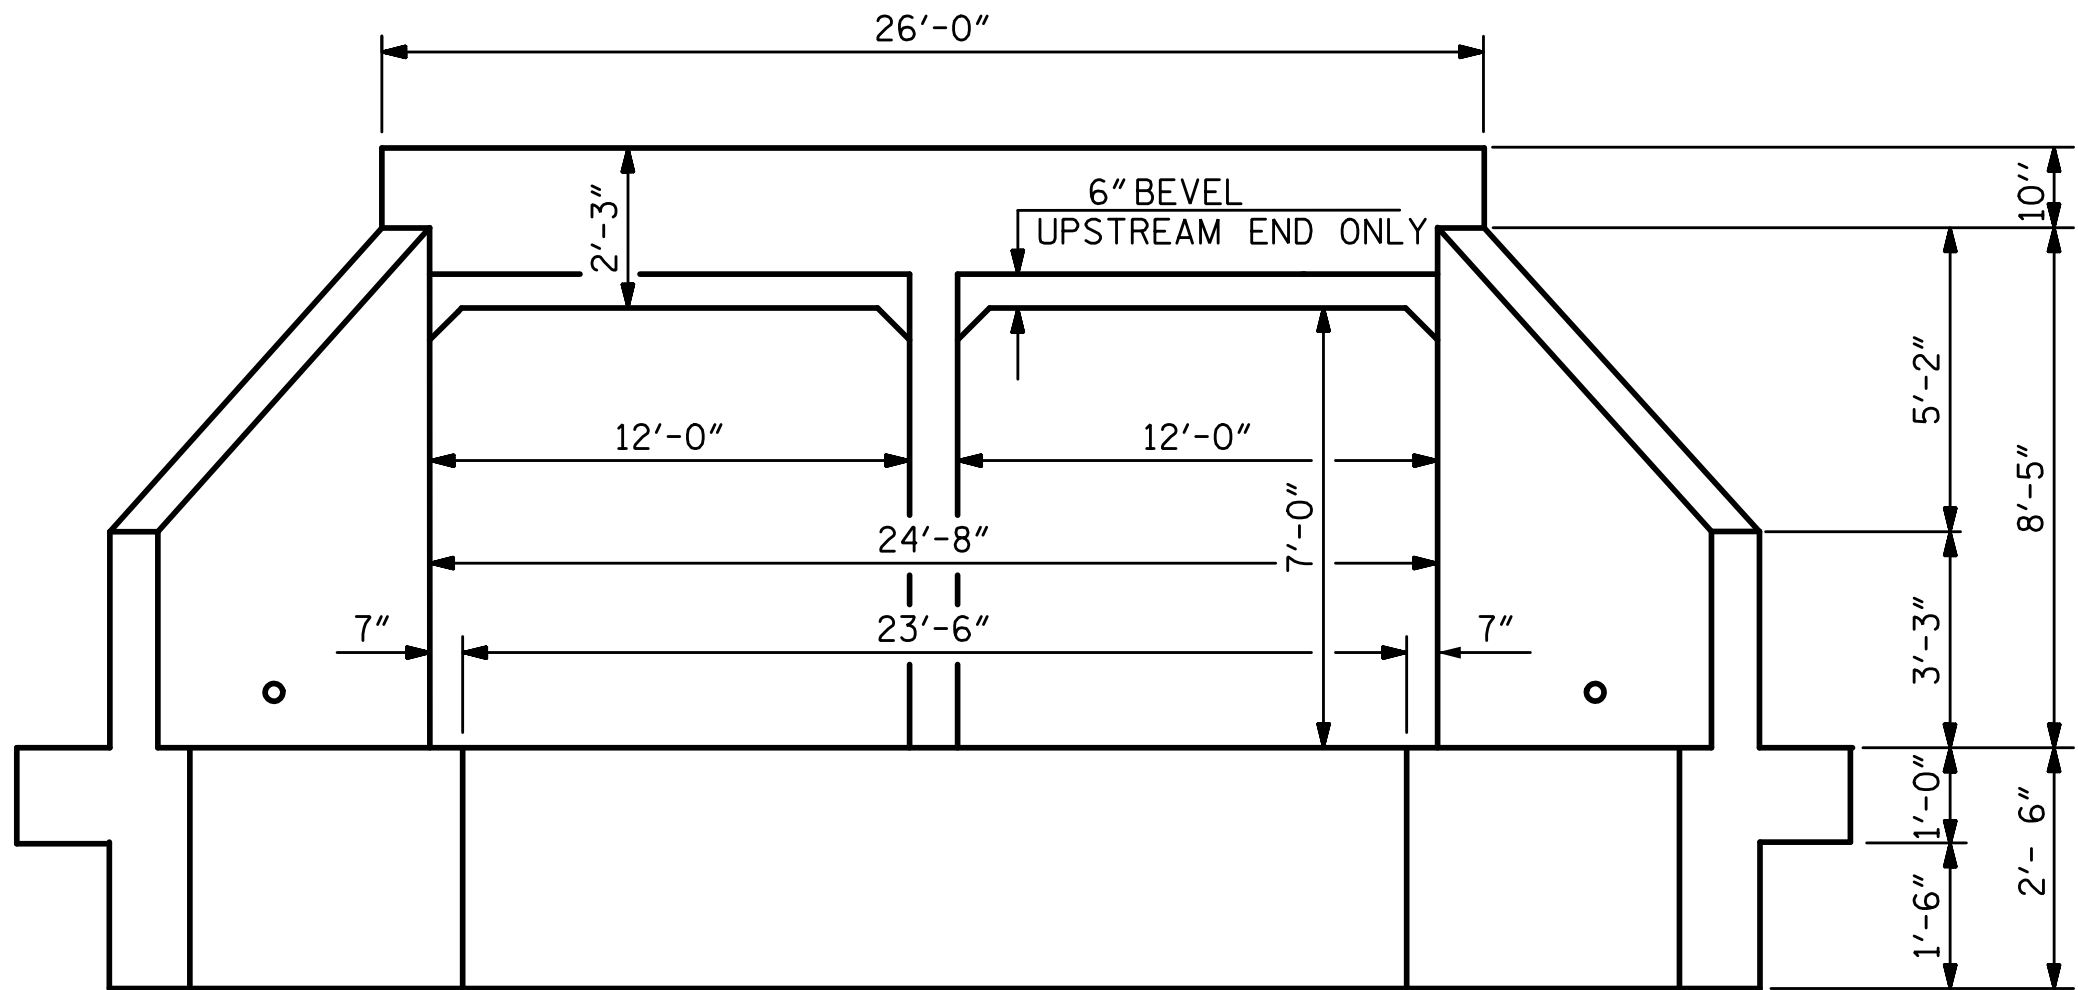

END ELEVATION - LOOKING DOWNSTREAM


(UPSTREAM END SHOWN, DOWNSTREAM END SIMILAR)

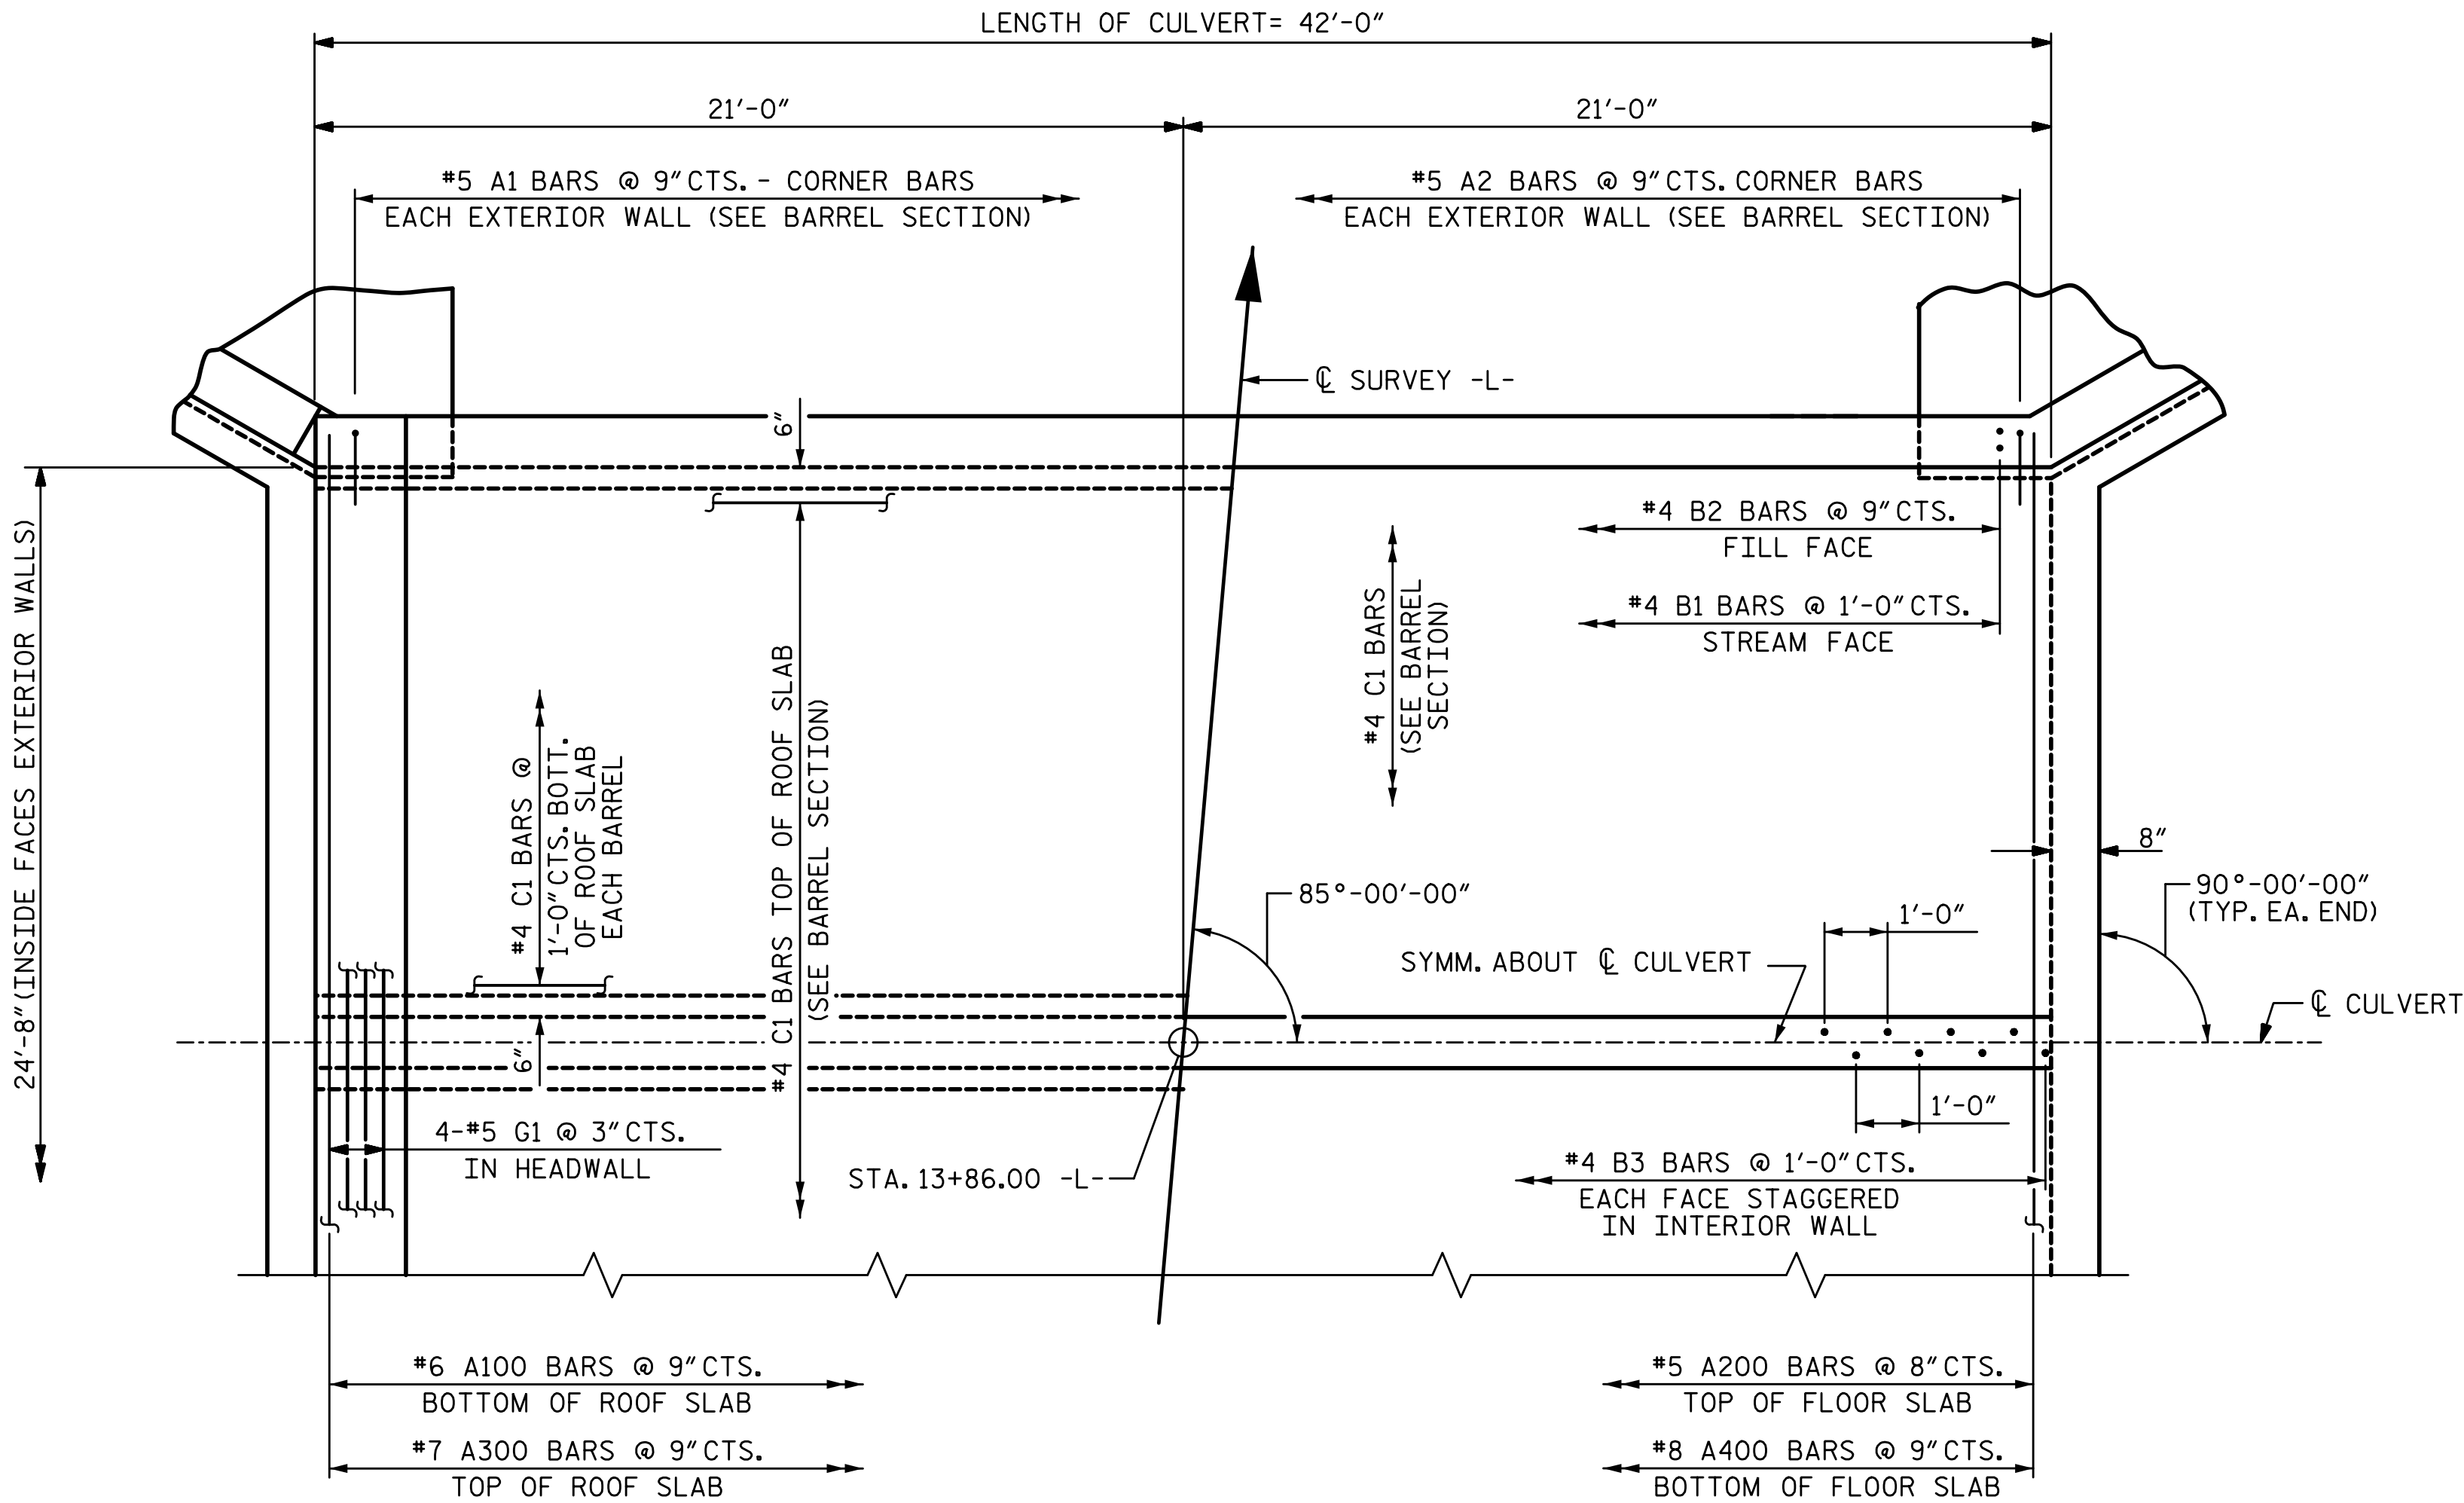

PART PLAN - ROOF SLAB

PART PLAN - FLOOR SLAB

(C1 BARS ARE 2 BAR RUNS) (CONCRETE SILLS NOT SHOWN FOR CLARITY)

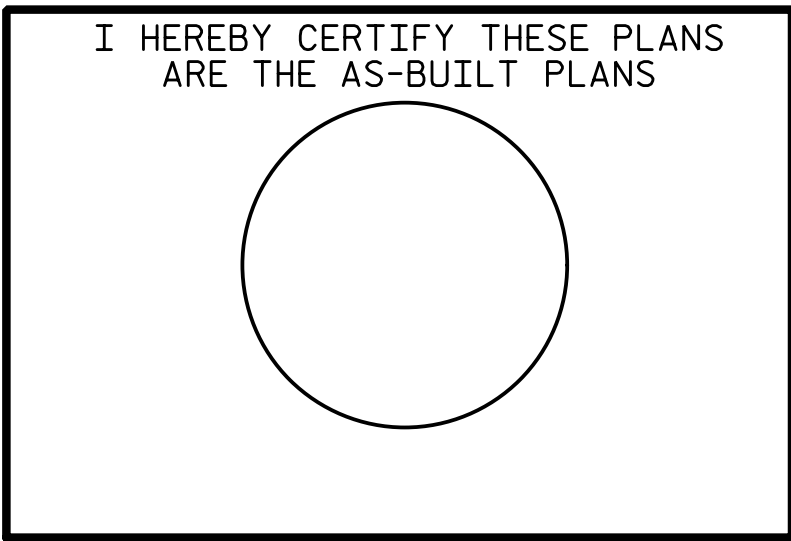

PROJECT NO. 17BP.7.R.99
ORANGE COUNTY
STATION: 13+86.00 -L-

SHEET 2 OF 6

STATE OF NORTH CAROLINA
DEPARTMENT OF TRANSPORTATION
RALEIGH

DOUBLE 12 FT. X 7 FT.
CONCRETE BOX CULVERT

85° SKEW

REVISIONS						SHEET NO.	
NO.	BY:	DATE:	NO.	BY:	DATE:	C-2	
1			3			TOTAL SHEETS	
2			4			6	

PLANS PREPARED BY:

SEMPSON
& ASSOCIATES
ENGINEERS

5640 Dillard Drive
Suite 200
Cary, NC 27518
(919) 852-0468
(919) 852-0598 (Fax)
www.simpsonengr.com


LICENSURE NO. C-2521




2/15/2017

DOCUMENT NOT CONSIDERED FINAL
UNLESS ALL SIGNATURES COMPLETED

2/15/2017 9:39:13 AM G:\Projects\2015\Division 7 (Hatch Mot)\17BP7R99 (Orange 209) (012X7 Culvert)\Structures\Drawings\Final\410_17BP7R99_SMU_CU.dgn

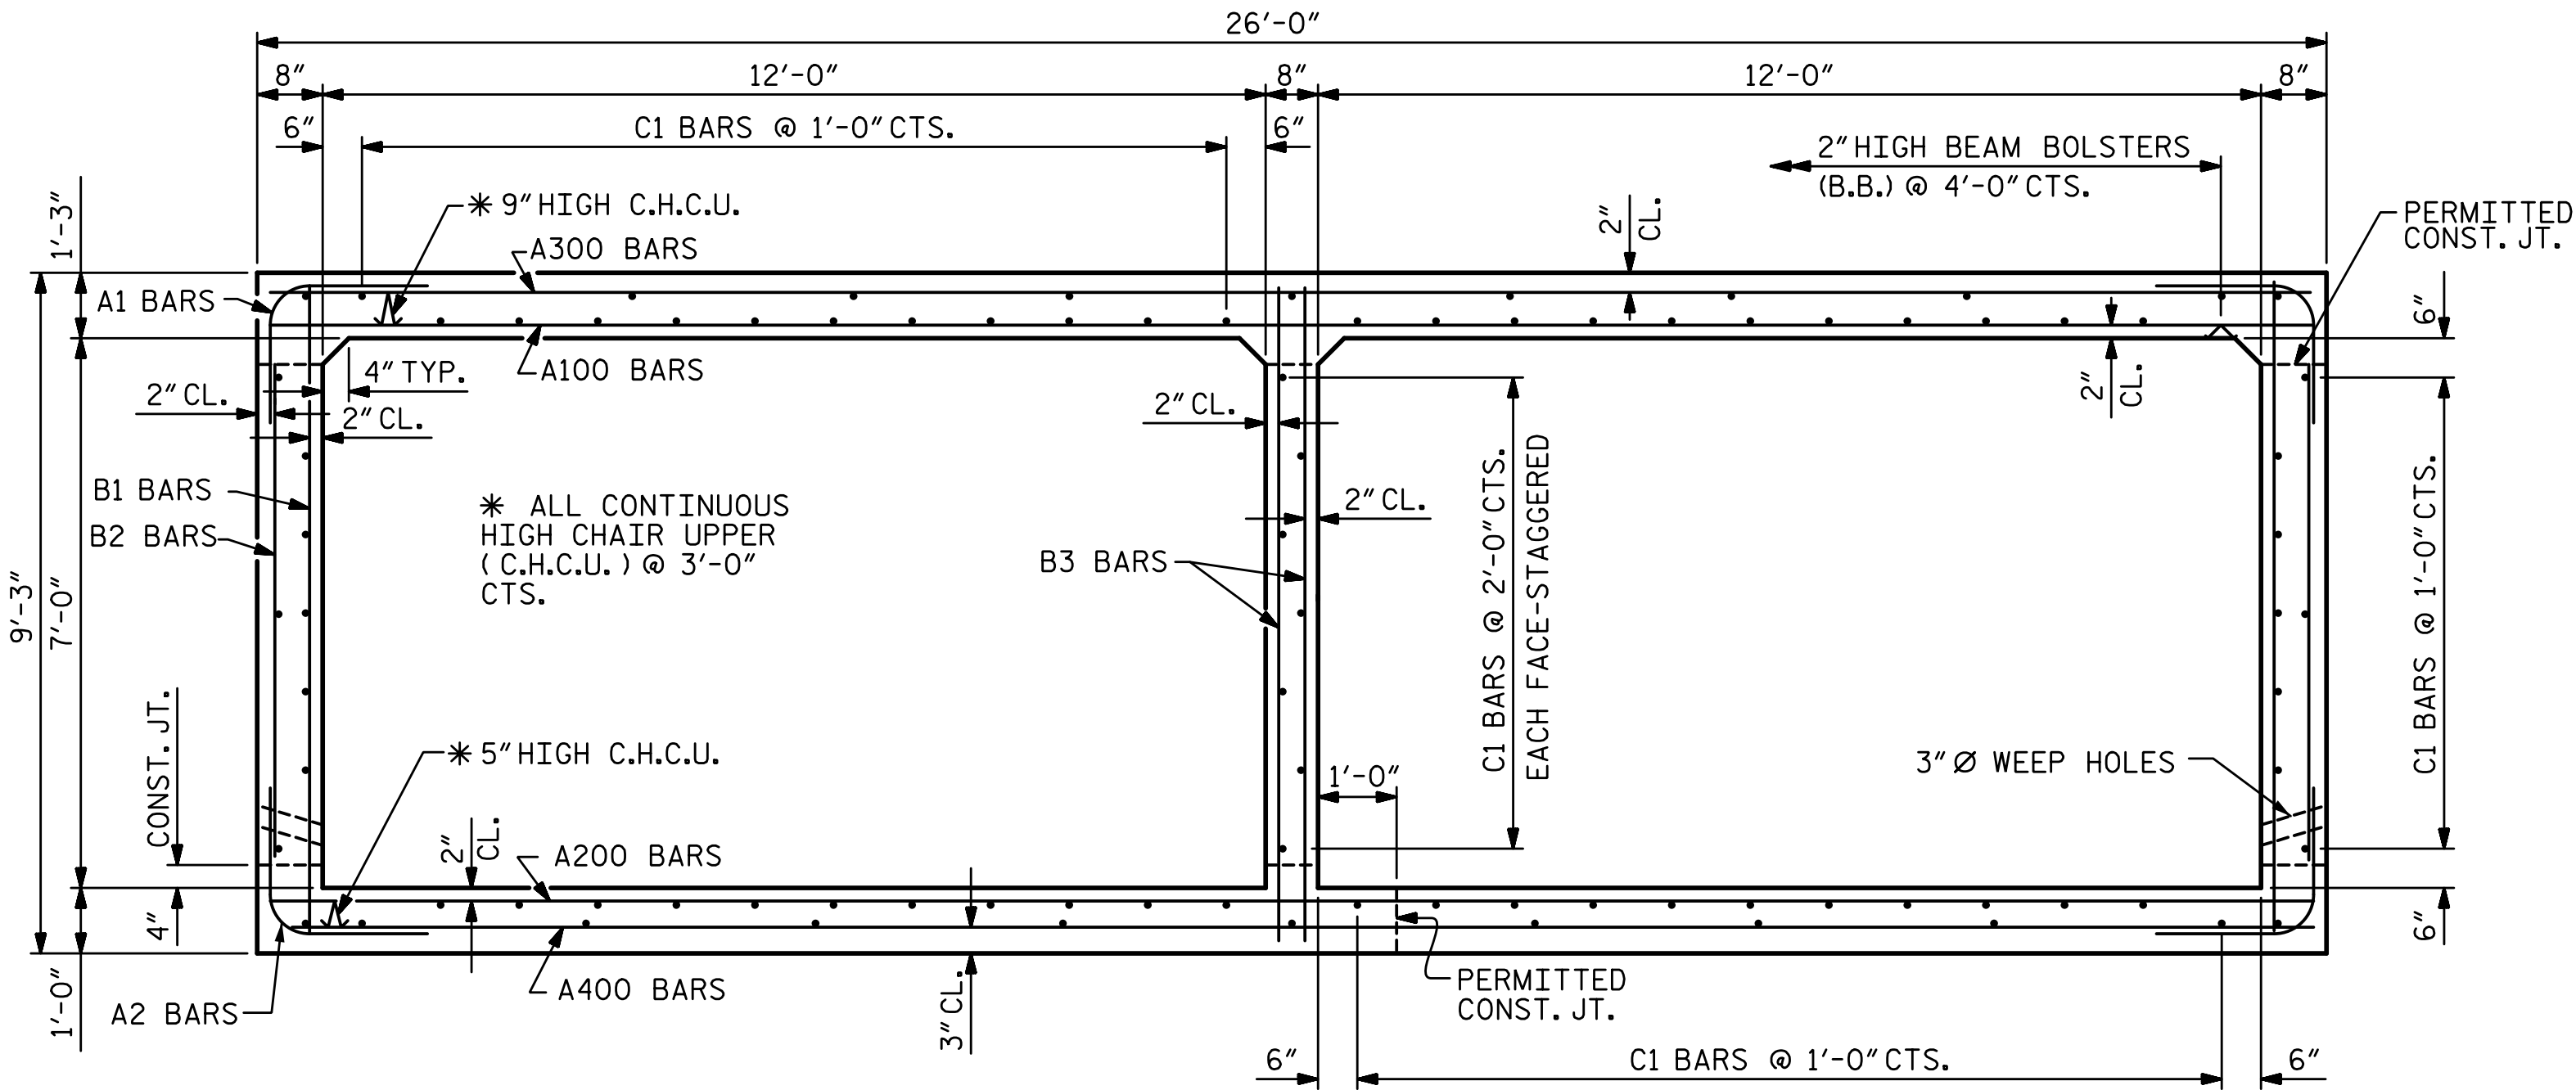


SECTION OF BARREL
(THERE ARE 89 "C" BARS IN SECTION OF BARREL)

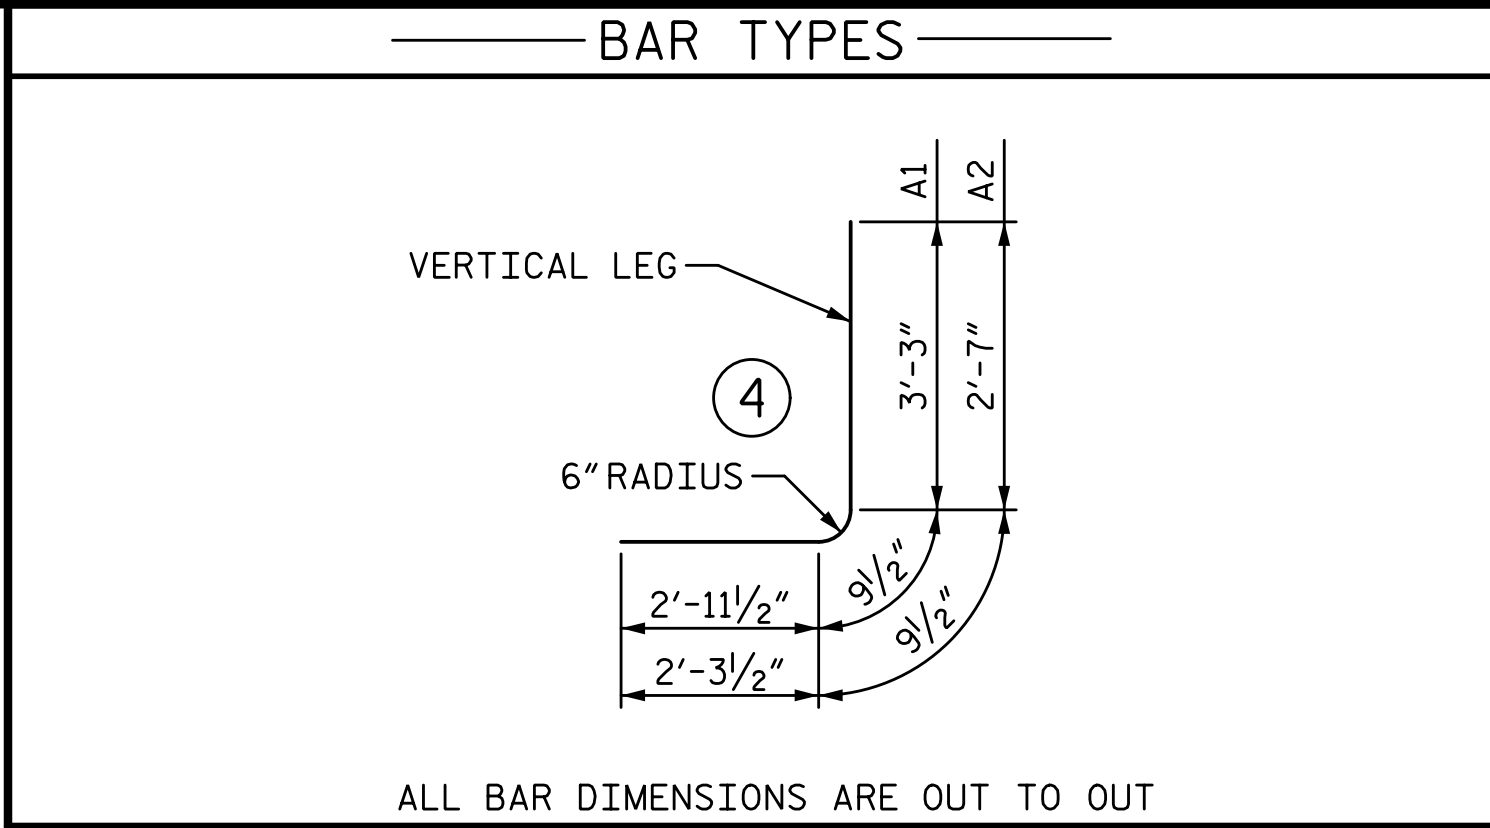


BILL OF MATERIAL					
BAR	NO.	SIZE	TYPE	LENGTH	WEIGHT
A1	112	5	4	7'-0"	818
A2	112	5	4	5'-8"	662
A100	56	6	STR	25'-7"	2152
A200	63	5	STR	25'-7"	1681
A300	56	7	STR	25'-7"	2928
A400	56	8	STR	25'-7"	3825
B1	84	4	STR	8'-9"	491
B2	112	4	STR	6'-4"	474
B3	84	4	STR	8'-9"	491
C1	178	4	STR	21'-9"	2586
D1	6	6	STR	1'-6"	14
D2	6	6	STR	2'-6"	23
G1	8	5	STR	25'-6"	213
TOTAL REINFORCING STEEL					16358 LB
CLASS A CONCRETE BREAKDOWN					
BARREL					113.1 CY
HEADWALLS					2.4 CY
SILLS					2.7 CY


SPLICE CHART	
*4 B1 SPLICE LENGTH = 1'-9"	
*4 B3 SPLICE LENGTH = 1'-9"	
*4 C1 SPLICE LENGTH = 1'-11"	
*5 A200 SPLICE LENGTH = 2'-2"	
*8 A400 SPLICE LENGTH = 4'-11"	

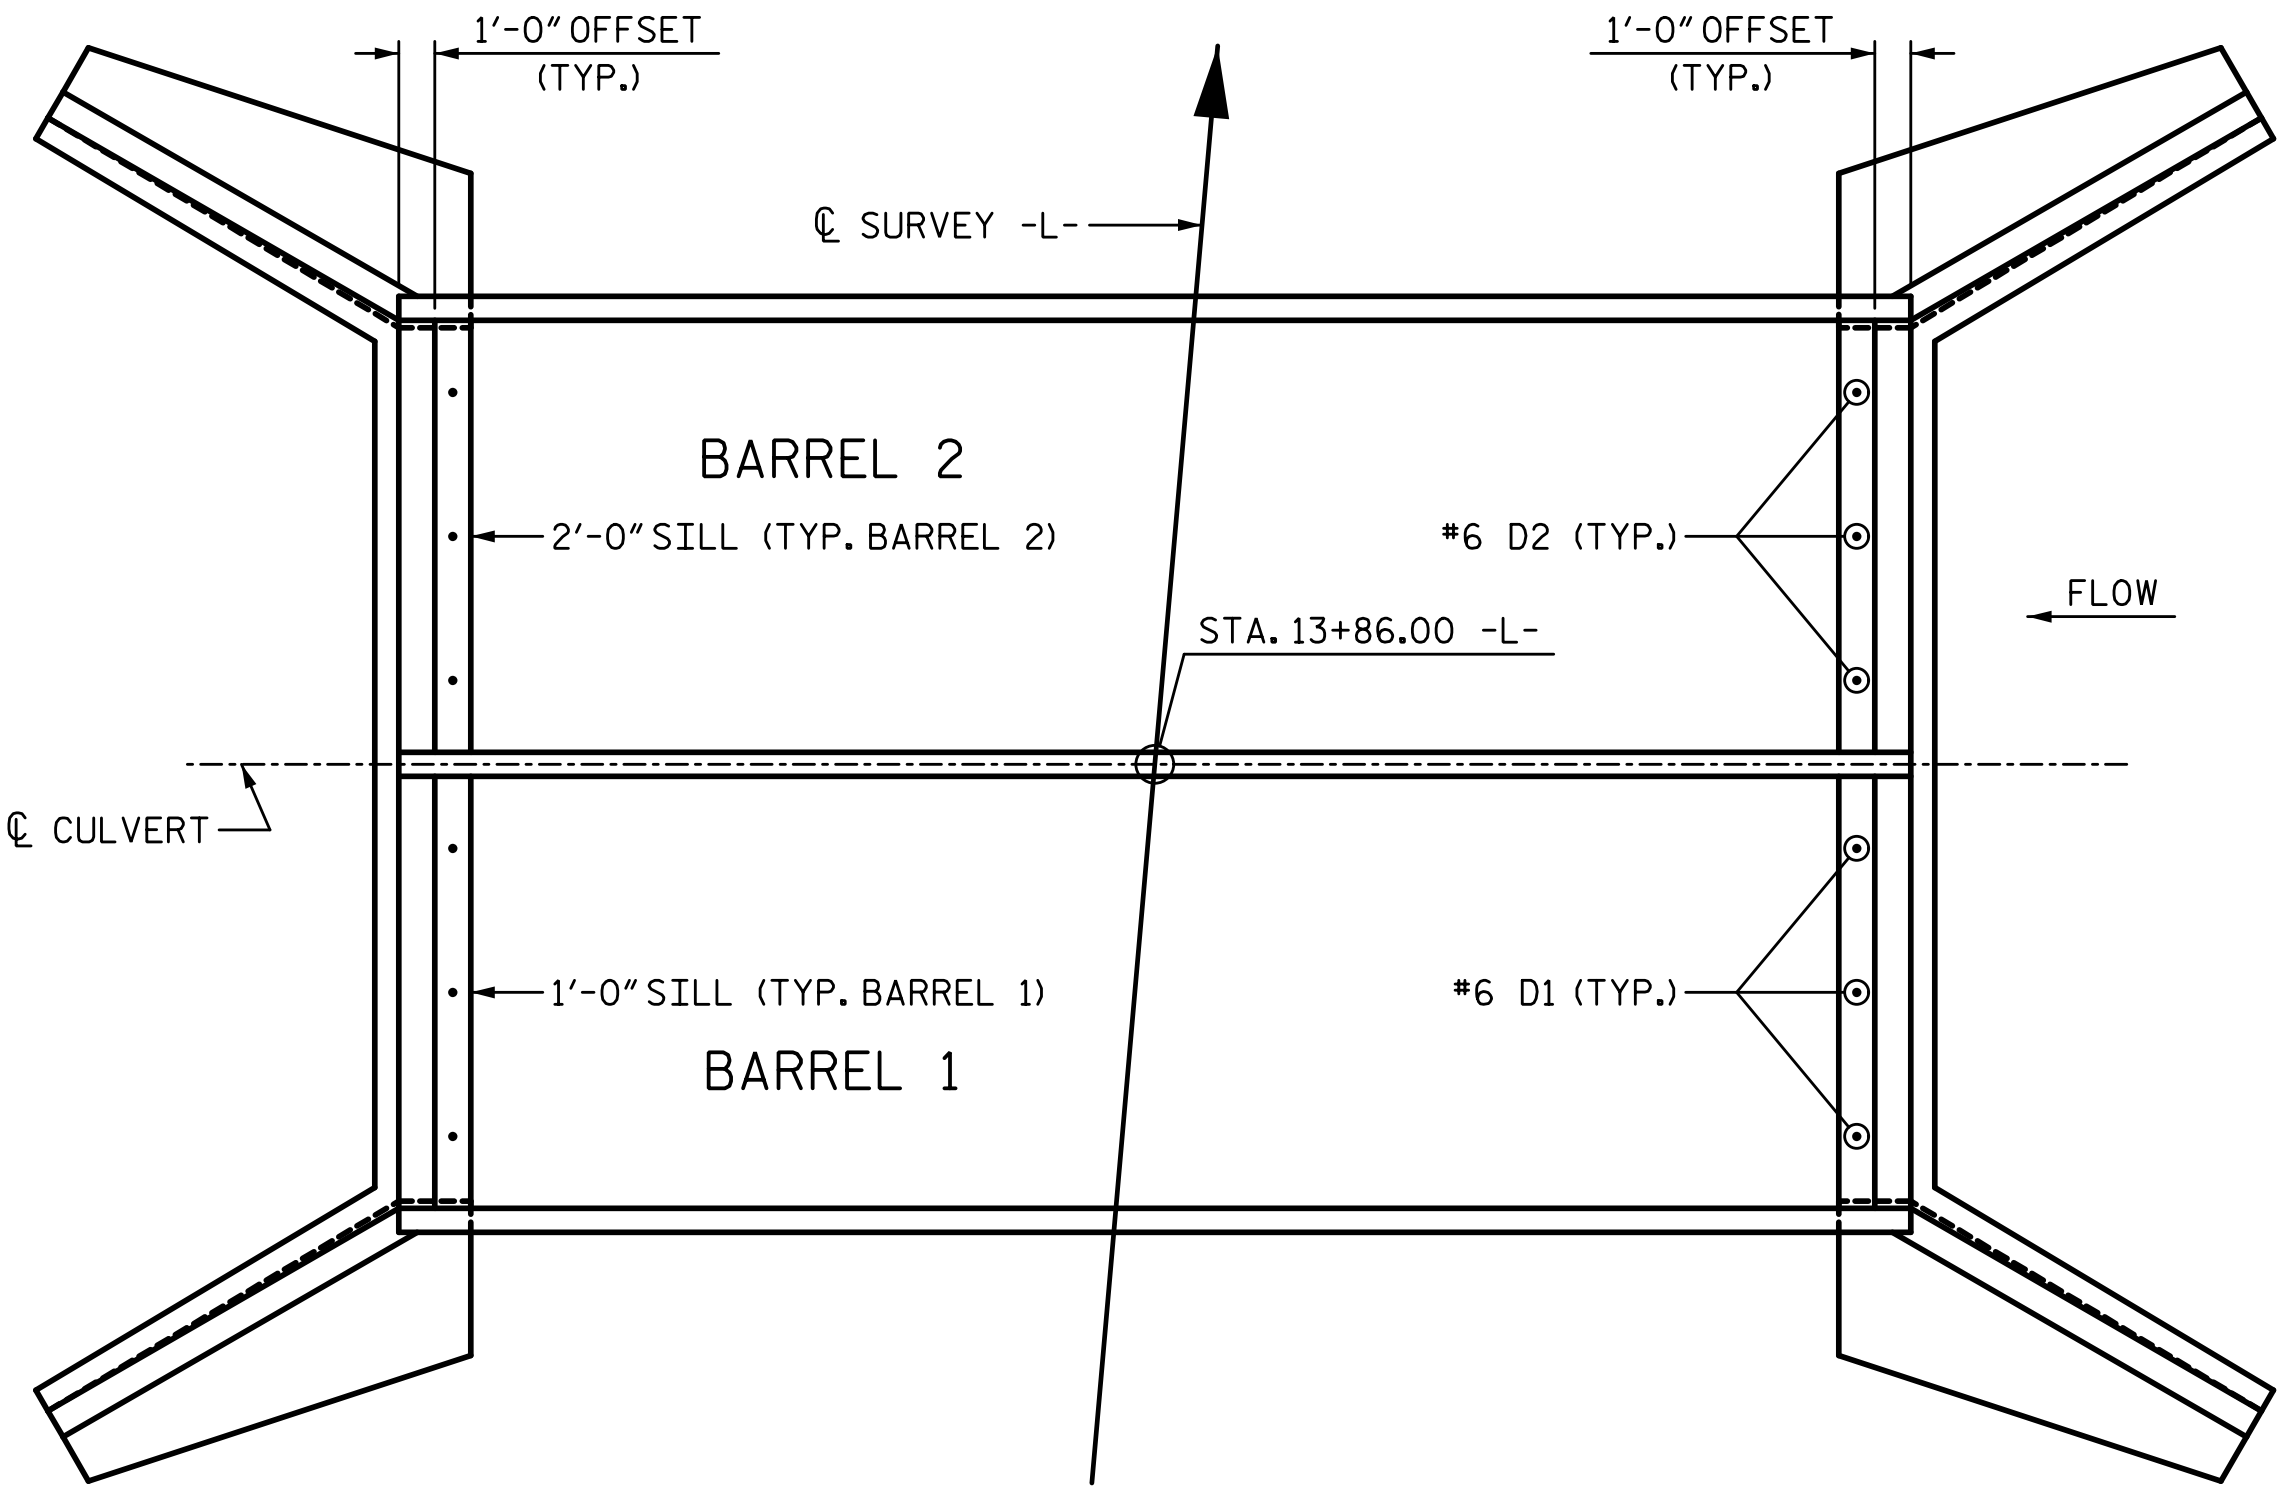

FLOOR PLAN
(SHOWING PLACEMENT OF SILLS)

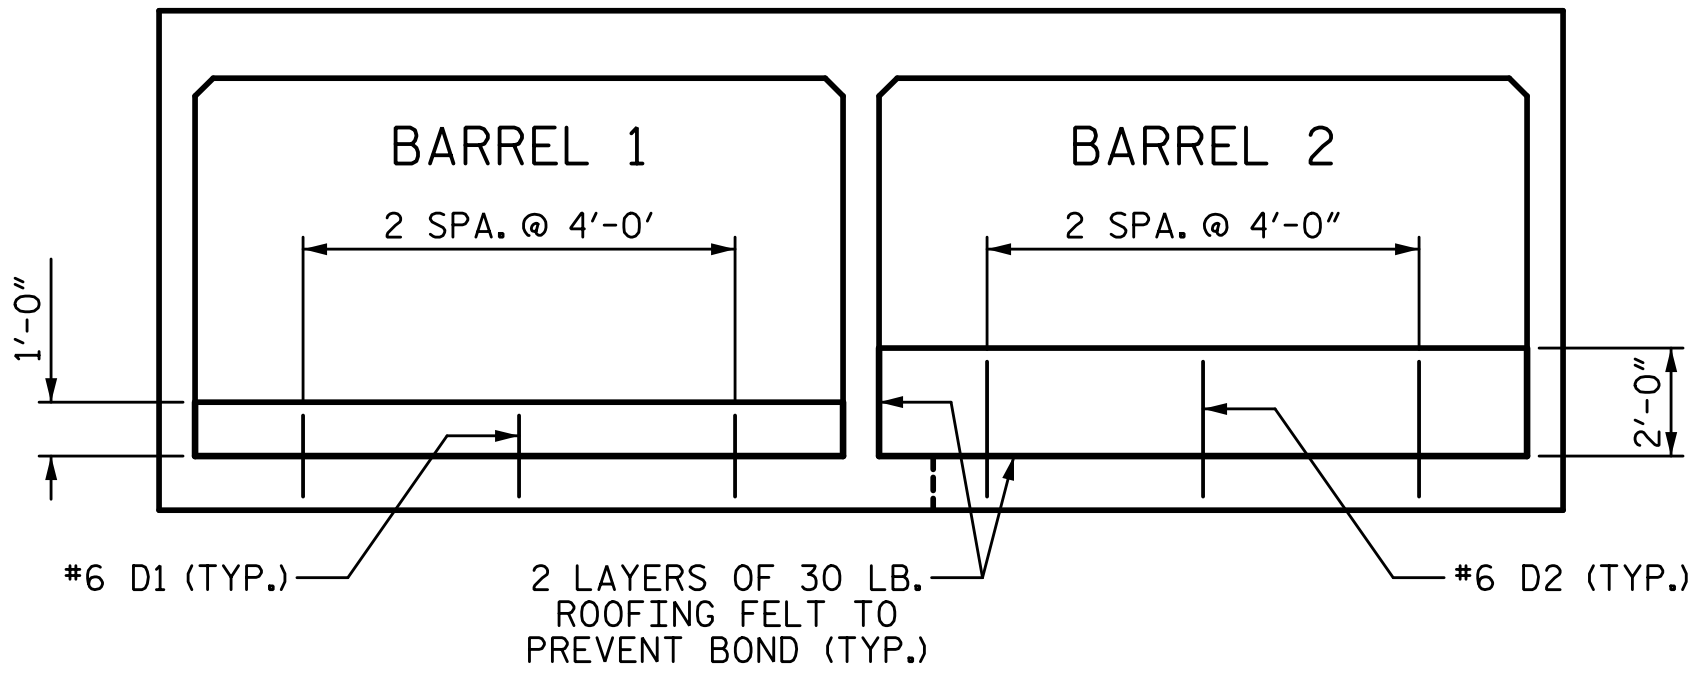

ELEVATION - LOOKING DOWNSTREAM

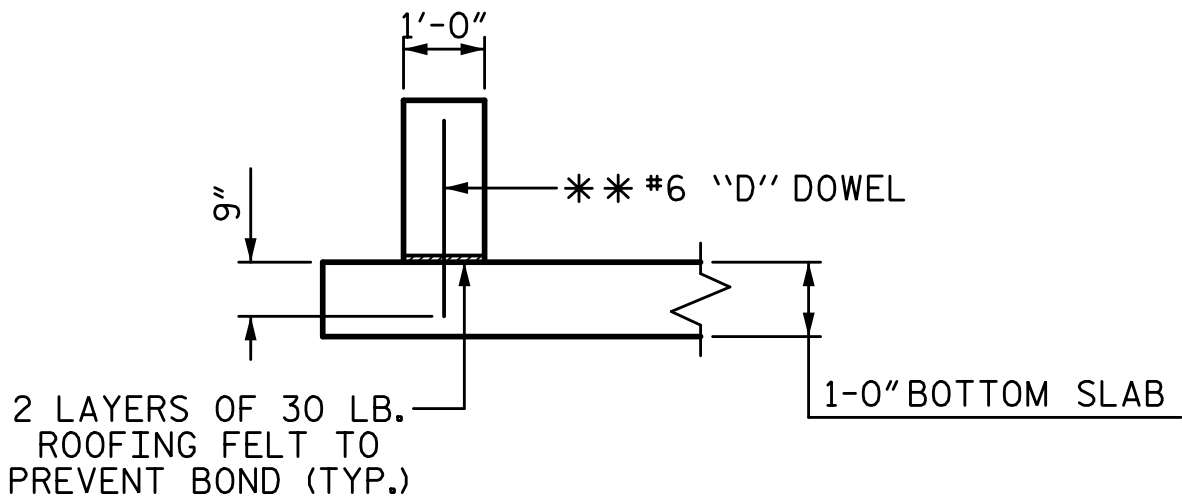

SECTION THROUGH SILL
**DOWELS MAY BE PUSHED INTO GREEN CONCRETE AFTER SLAB HAS BEEN FLOAT FINISHED.

PLANS PREPARED BY:

SIMPSON & ASSOCIATES
5640 Dillard Drive
Suite 200
Cary, NC 27518
(919) 852-0468
(919) 852-0598 (Fax)
www.simpsonengr.com
LICENSURE NO. C-2521



PROJECT NO. 17BP.7.R.99
ORANGE COUNTY
STATION: 13+86.00 -L-

SHEET 3 OF 6

STATE OF NORTH CAROLINA
DEPARTMENT OF TRANSPORTATION
RALEIGH

DOUBLE 12 FT. X 7 FT.
CONCRETE BOX CULVERT

85° SKEW


REVISIONS					SHEET NO. C-3
NO.	BY:	DATE:	NO.	BY:	
1			3		TOTAL SHEETS 6
2			4		

DOCUMENT NOT CONSIDERED FINAL
UNLESS ALL SIGNATURES COMPLETED


DRAWN BY: <u>T. BANKOVICH</u>	DATE: <u>7-16</u>
CHECKED BY: <u>B.S. COX</u>	DATE: <u>7-16</u>
DESIGN ENGINEER OF RECORD: <u>B.S. COX</u>	DATE: <u>7-16</u>

CULVERT SILL DETAILS
BACKFILL BARREL 1 WITH 1'-0" OF NATIVE MATERIALS
BACKFILL BARREL 2 WITH 2'-0" OF NATIVE MATERIALS
(SEE CULVERT SURVEY AND HYDRAULIC DESIGN REPORT FOR DESCRIPTION OF AND PLACEMENT OF NATIVE MATERIALS.)


2/15/2017 9:39:13 AM G:\Projects\2015\Division 7 (Hatch Mot)\17BP7R99 (Orange 209) (012X7 Culvert)\Structures\Drawings\Final\410_17BP7R99_SMU_CU.dgn

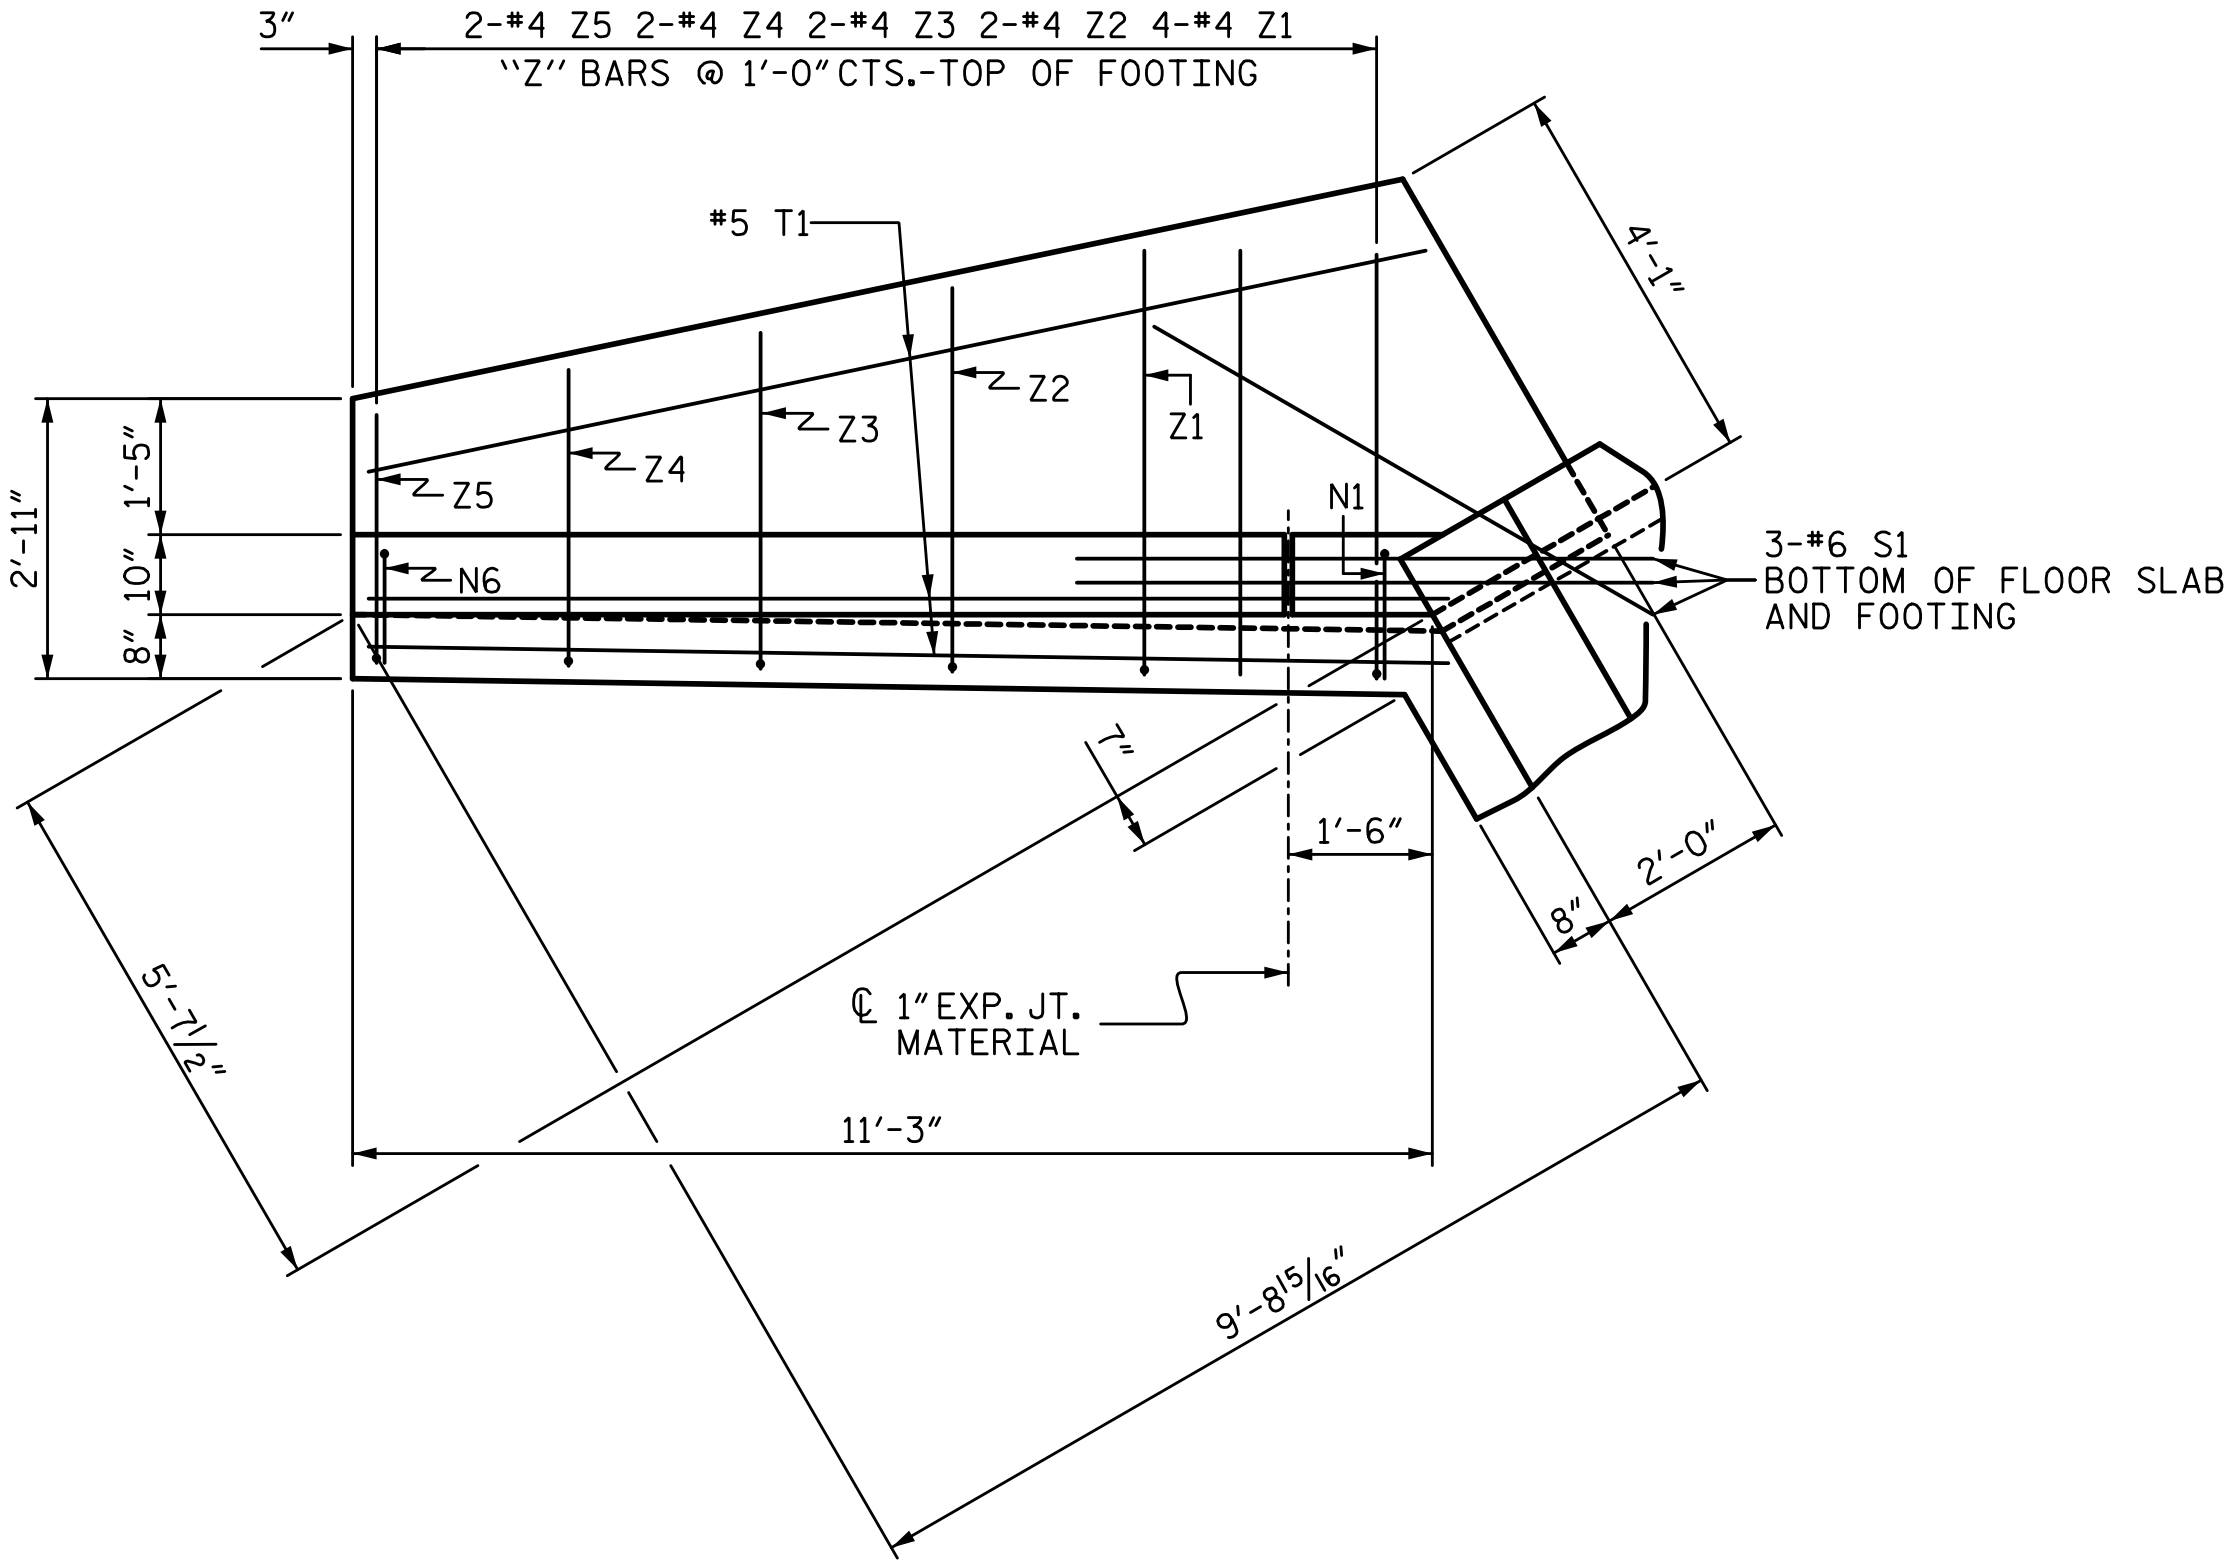

PLAN

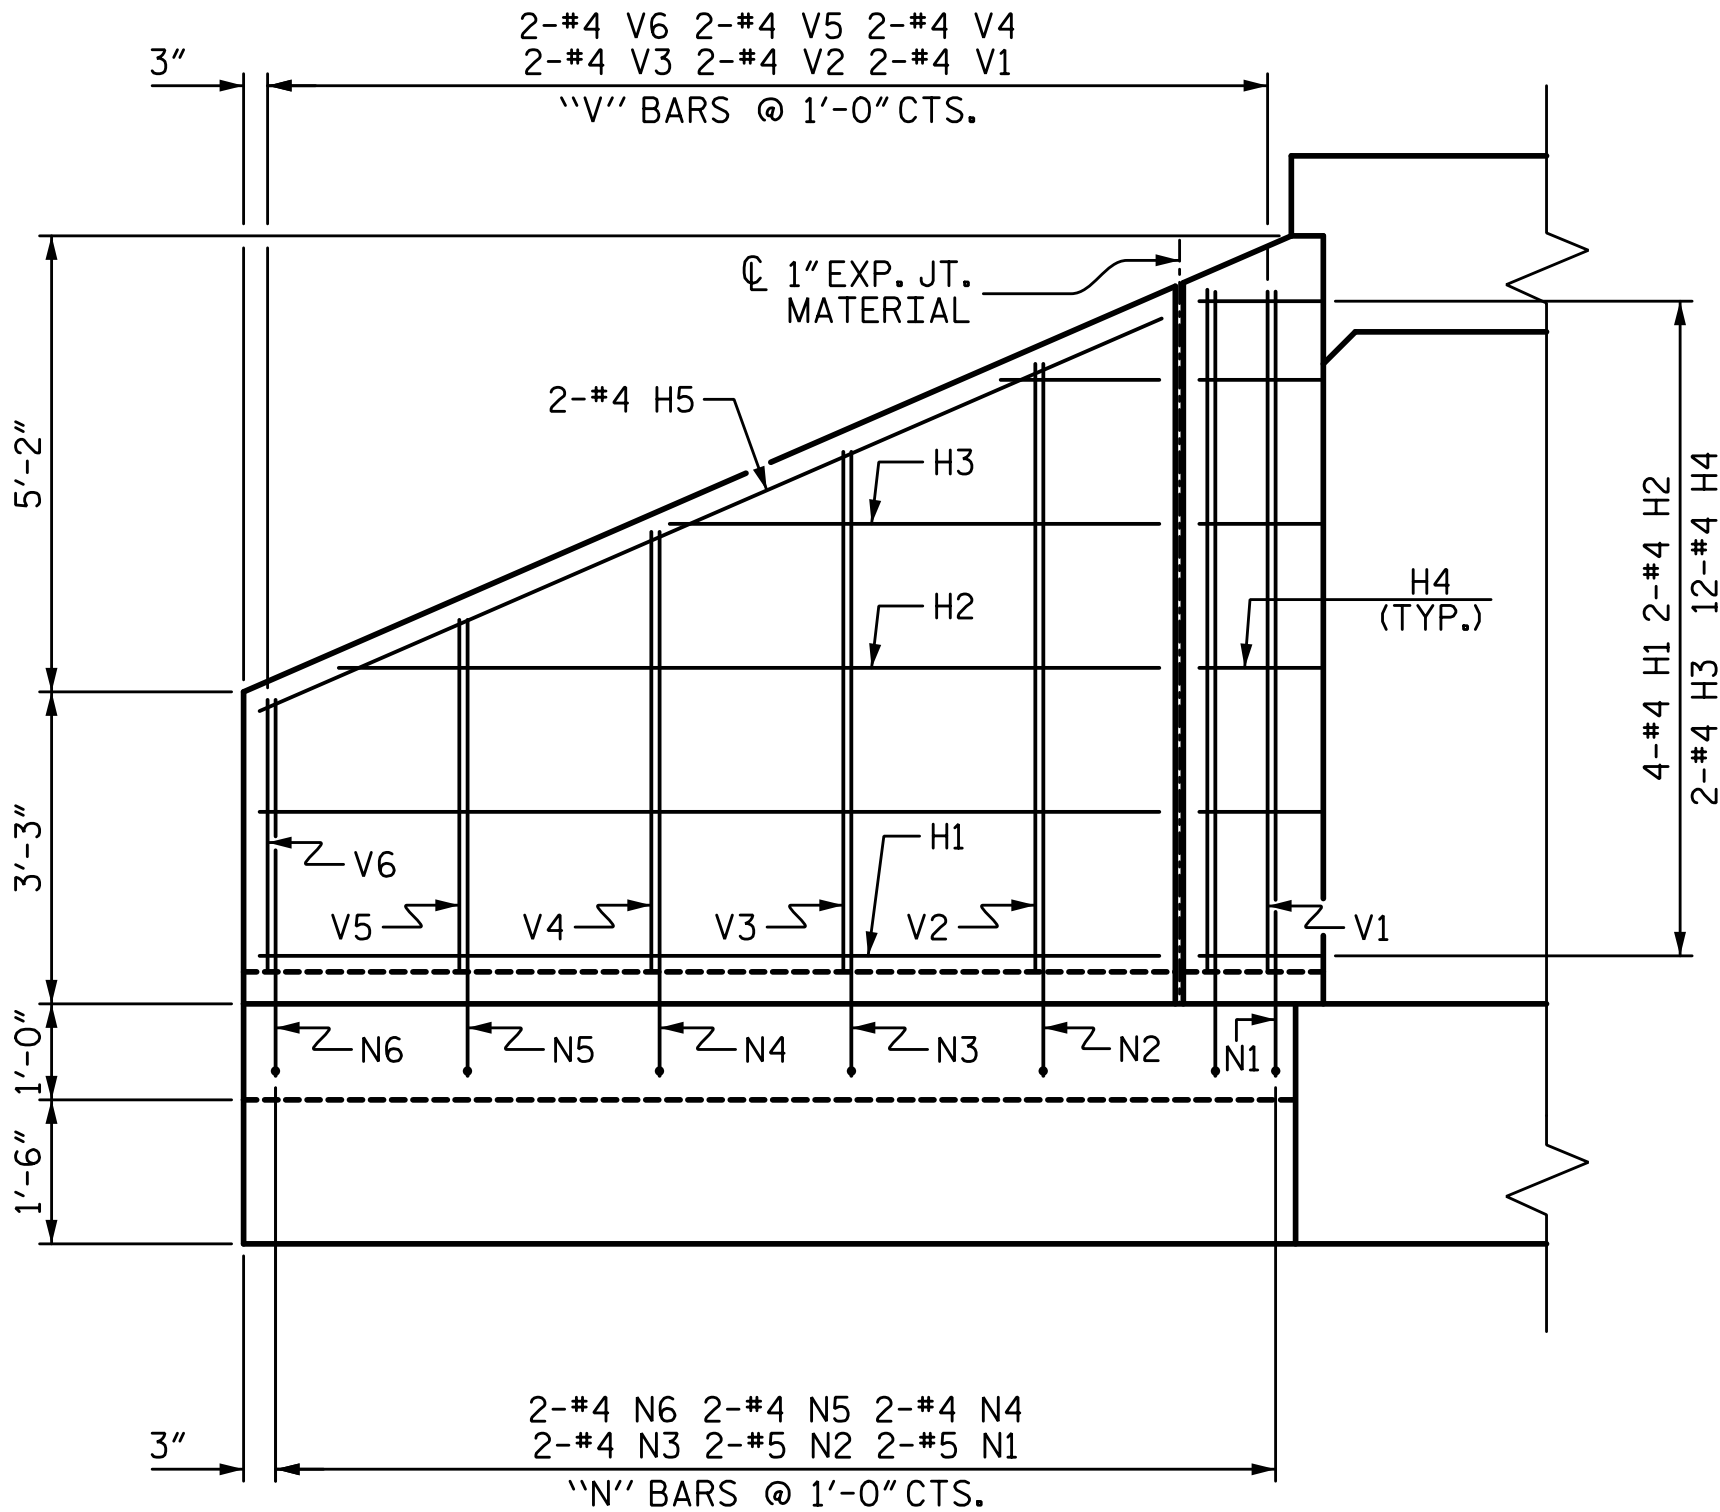




ELEVATION

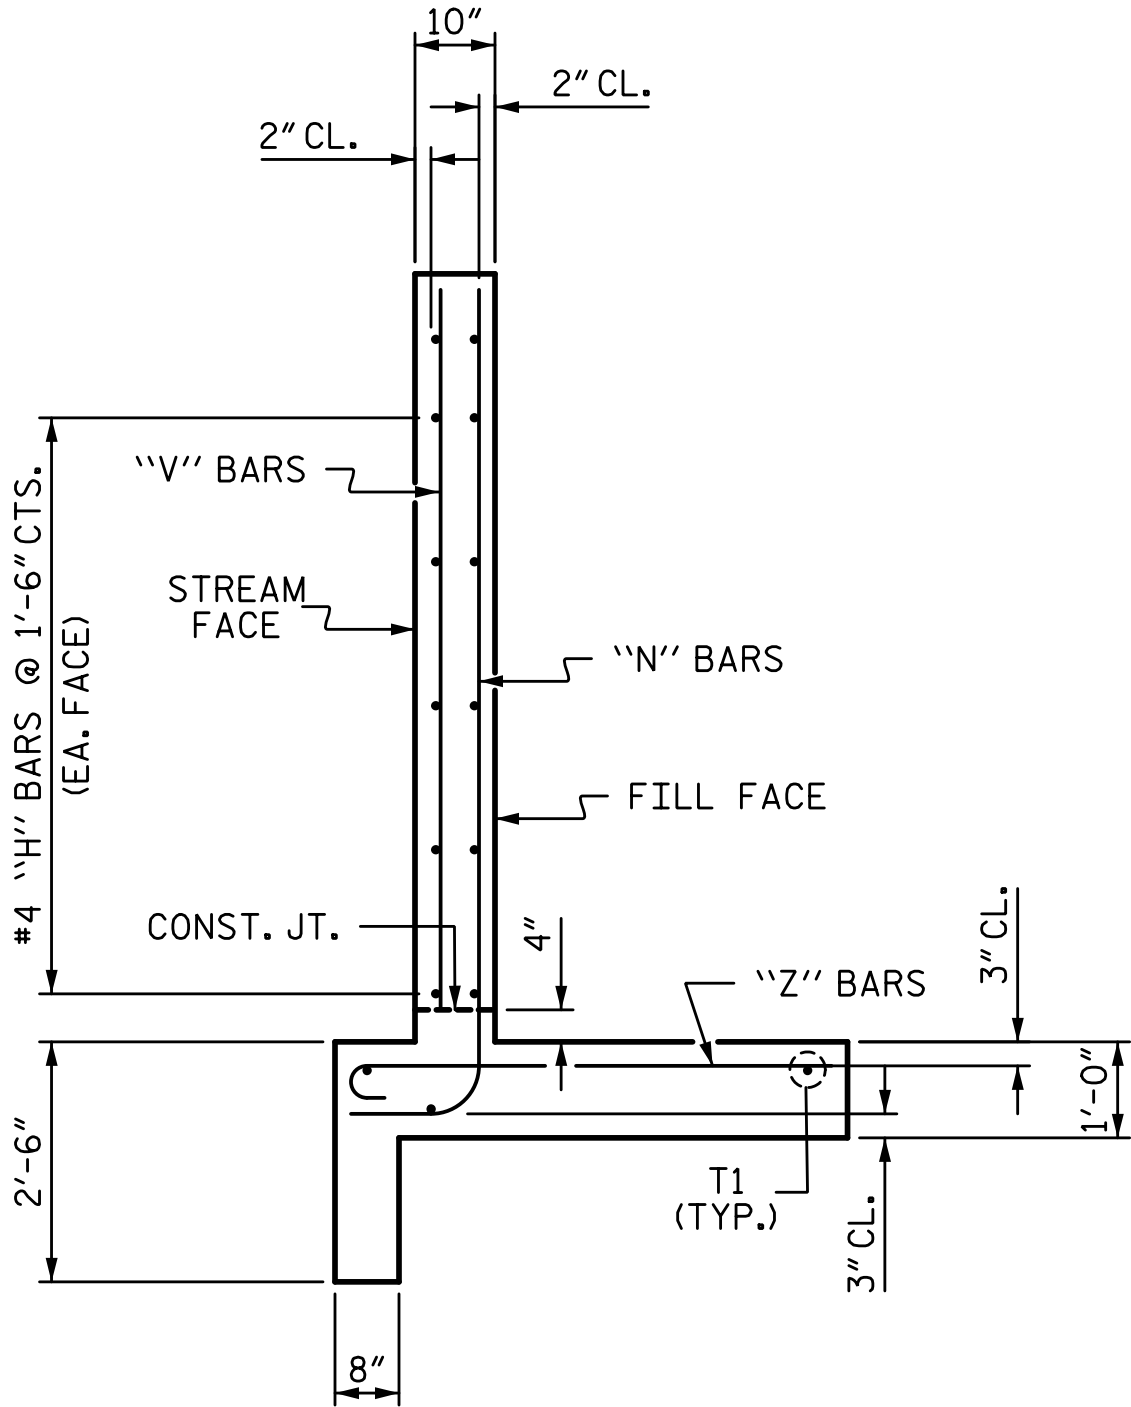

TYPICAL WING SECTION

BAR TYPES

ALL BAR DIMENSIONS ARE OUT TO OUT.

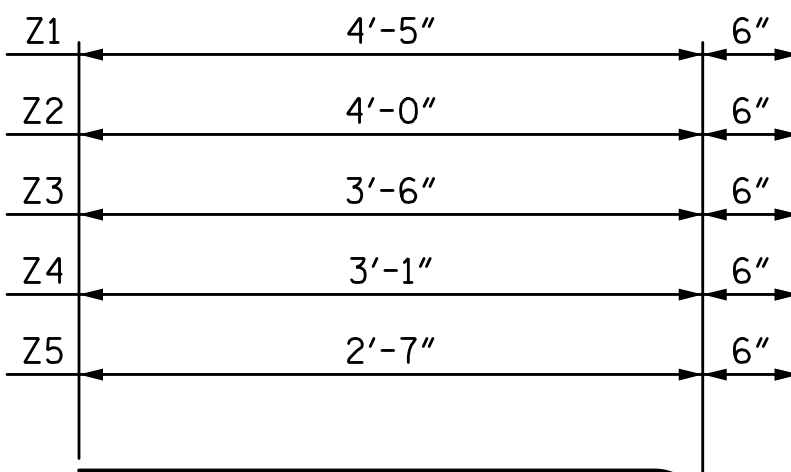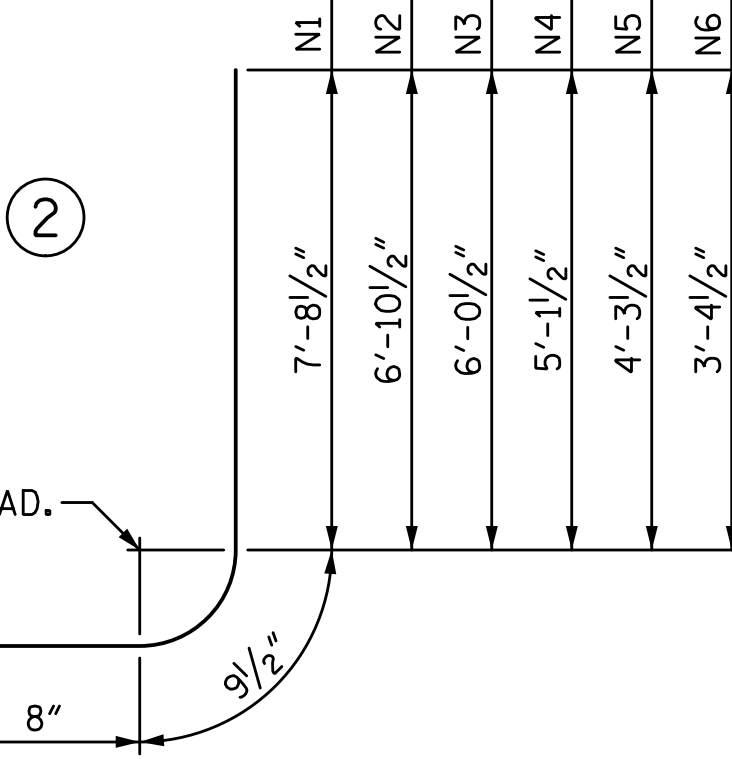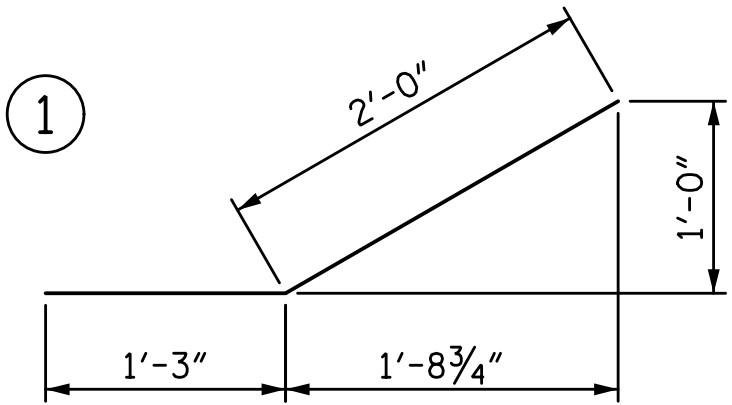

3

BILL OF MATERIAL

BAR	NO.	SIZE	TYPE	LENGTH	WEIGHT
H1	16	4	STR	9'-4"	100
H2	8	4	STR	8'-6"	45
H3	8	4	STR	5'-1"	27
H4	48	4	1	3'-3"	104
H5	8	4	STR	10'-3"	55
N1	8	5	2	9'-2"	76
N2	8	5	2	8'-4"	70
N3	8	4	2	7'-6"	40
N4	8	4	2	6'-7"	35
N5	8	4	2	5'-9"	31
N6	8	4	2	4'-10"	26
S1	12	6	STR	6'-0"	108
T1	12	5	STR	11'-3"	141
V1	8	4	STR	7'-1"	38
V2	8	4	STR	6'-4"	34
V3	8	4	STR	5'-5"	29
V4	8	4	STR	4'-7"	24
V5	8	4	STR	3'-8"	20
V6	8	4	STR	2'-10"	15
Z1	16	4	3	4'-11"	53
Z2	8	4	3	4'-6"	24
Z3	8	4	3	4'-0"	21
Z4	8	4	3	3'-7"	19
Z5	8	4	3	3'-1"	16

TOTAL REINFORCING STEEL 1151 LB

CLASS A CONCRETE BREAKDOWN	
4 WINGS	17.1 CY
2 END CURTAIN WALLS	2.9 CY
TOTAL	20.0 CY

PROJECT NO. 17BP.7.R.99
ORANGE COUNTY
STATION: 13+86.00 -L-

SHEET 4 OF 6

STATE OF NORTH CAROLINA
DEPARTMENT OF TRANSPORTATION
RALEIGH

WINGS FOR
CONCRETE BOX CULVERT
H = 7'-0" SLOPE 2:1
90° SKEW

REVISIONS

NO.	BY:	DATE:	NO.	BY:	DATE:	SHEET NO.
1			3			C-4
2			4			TOTAL SHEETS 6

PLANS PREPARED BY:


SIMPSON
ENGINEERS
& ASSOCIATES
5640 Dillard Drive
Suite 200
Cary, NC 27518
(919) 852-0468
(919) 852-0598 (Fax)
www.simpsonengr.com
LICENSURE NO. C-2521



2/15/2017


DOCUMENT NOT CONSIDERED FINAL
UNLESS ALL SIGNATURES COMPLETED

2/15/2017 9:39:14 AM G:\Projects\2015\Division 7 (Hatch Mot)\17BP7R99 (Orange 209) (012X7 Culvert)\Structures\Drawings\Final\410_17BP7R99_SMU_CU.dgn

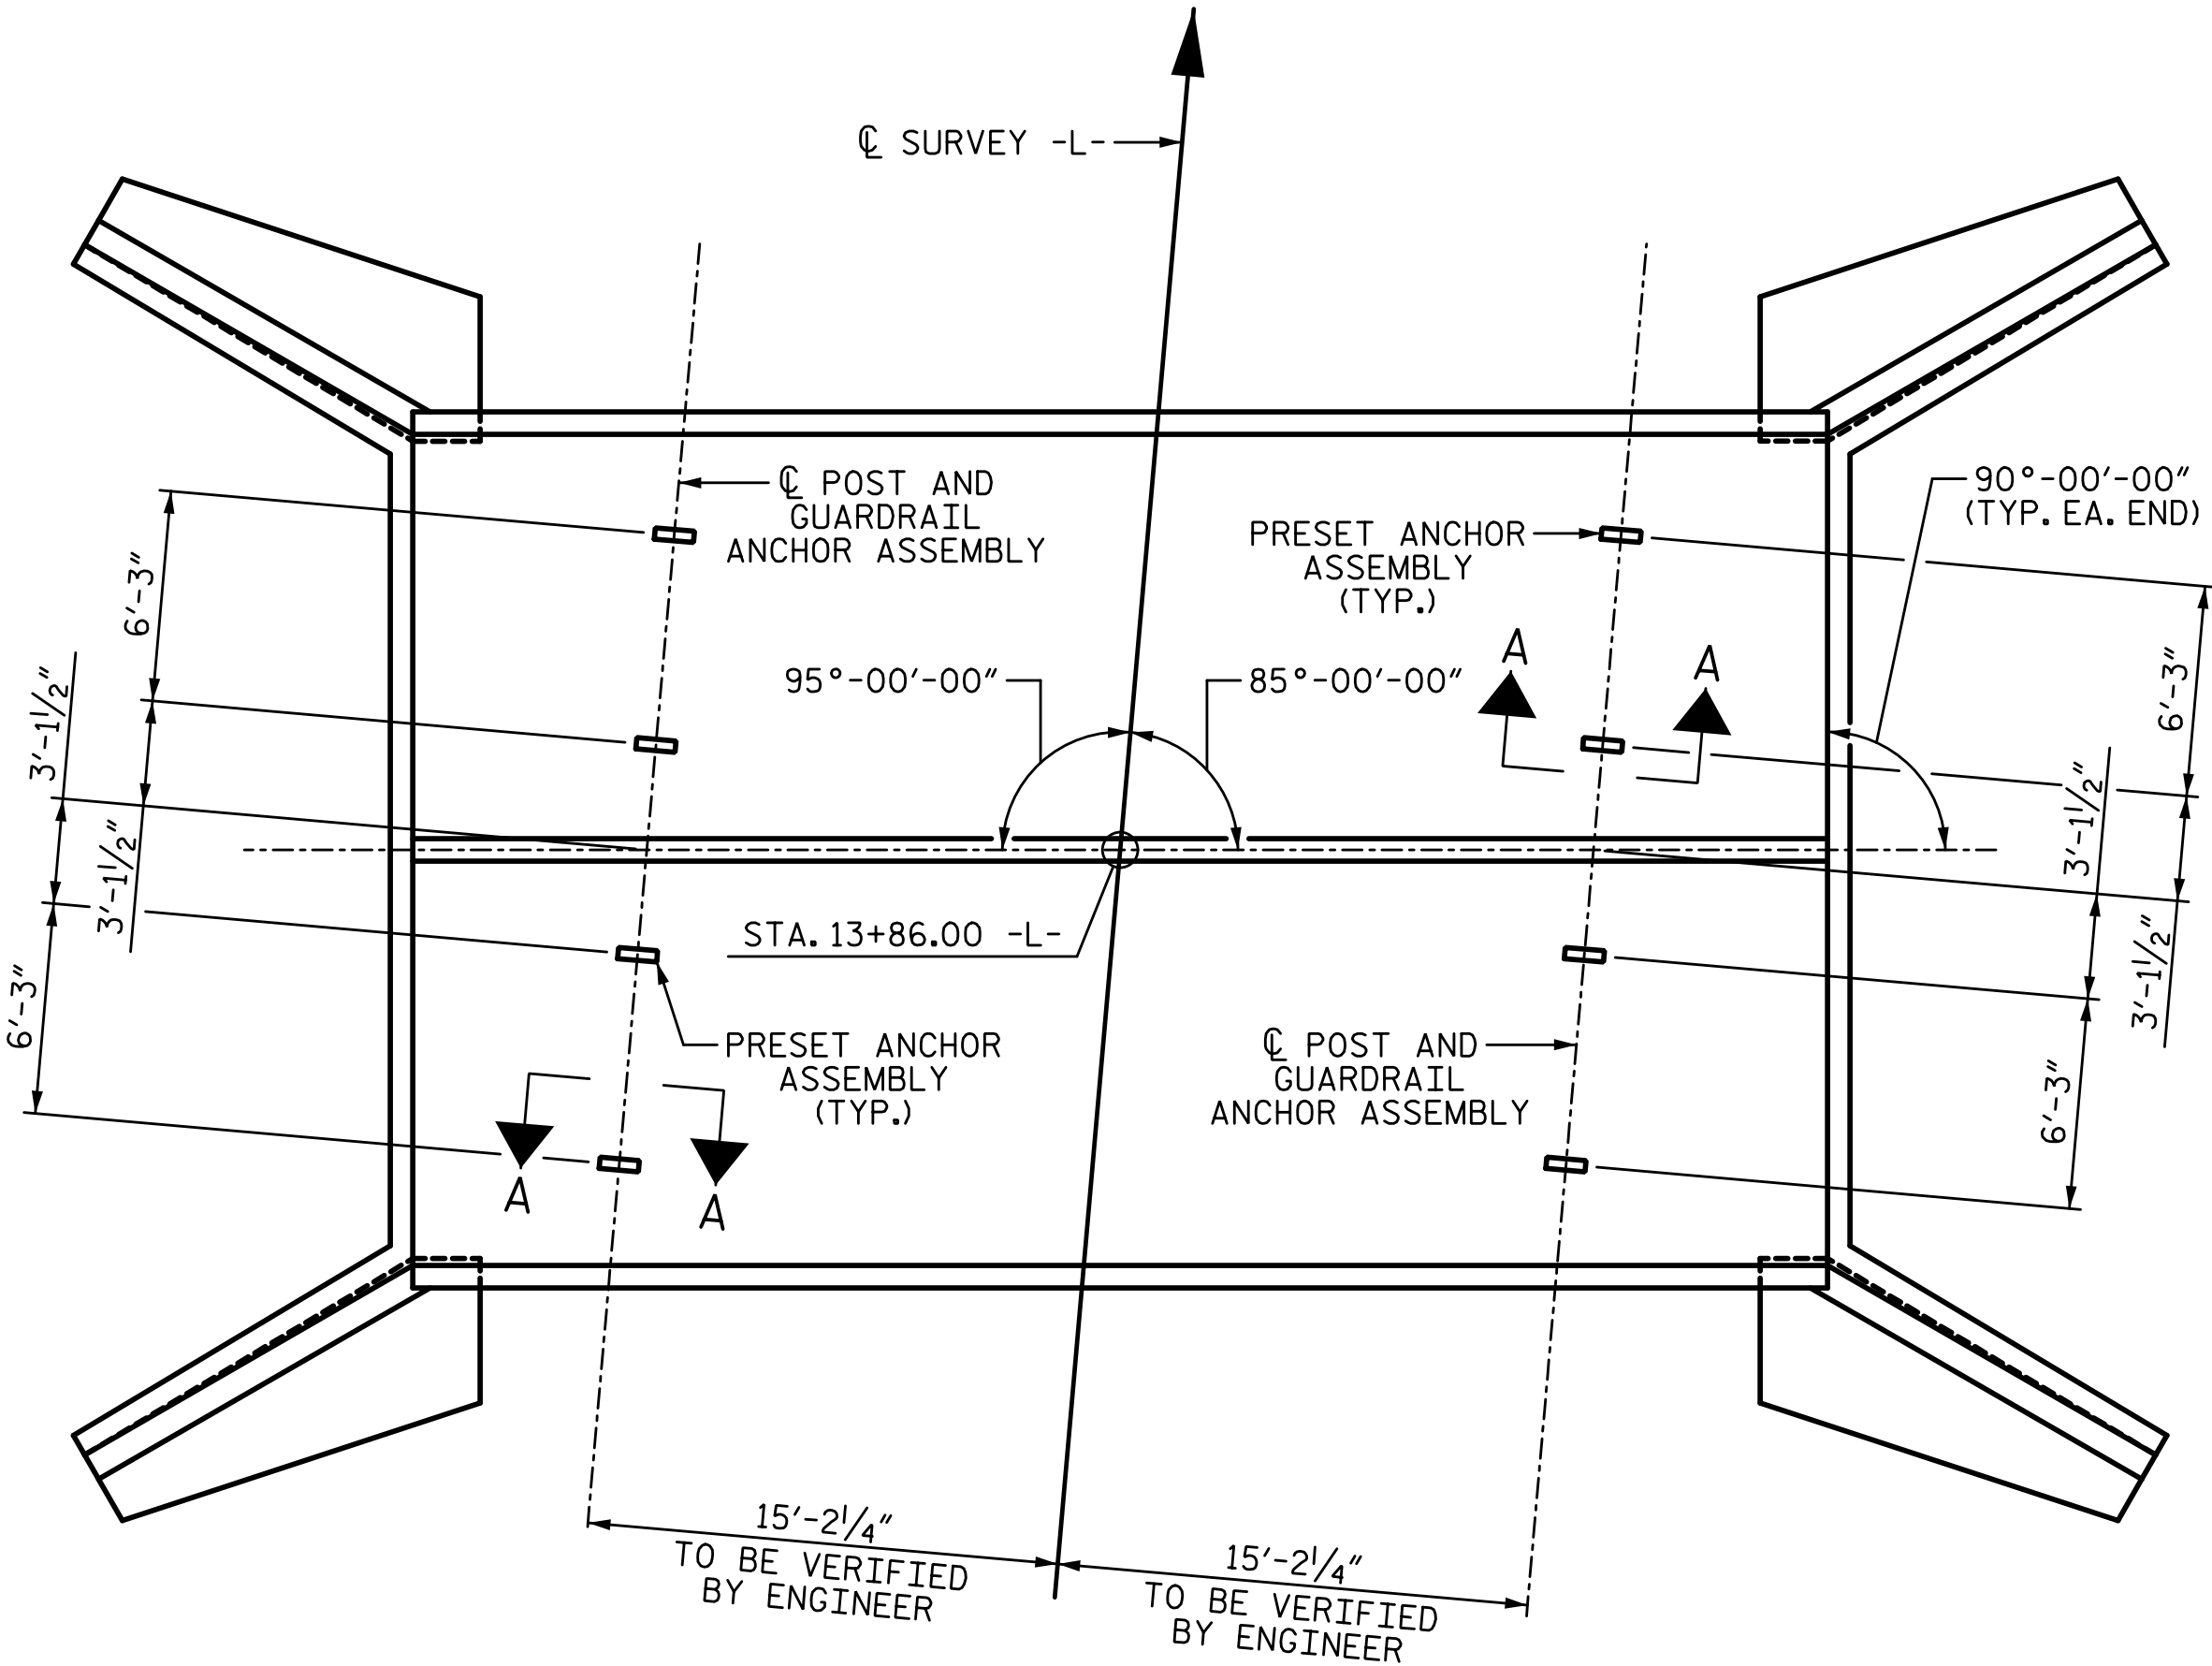


PLAN

(SHOWING GUARDRAIL ANHOR ASSEMBLY SPACING)

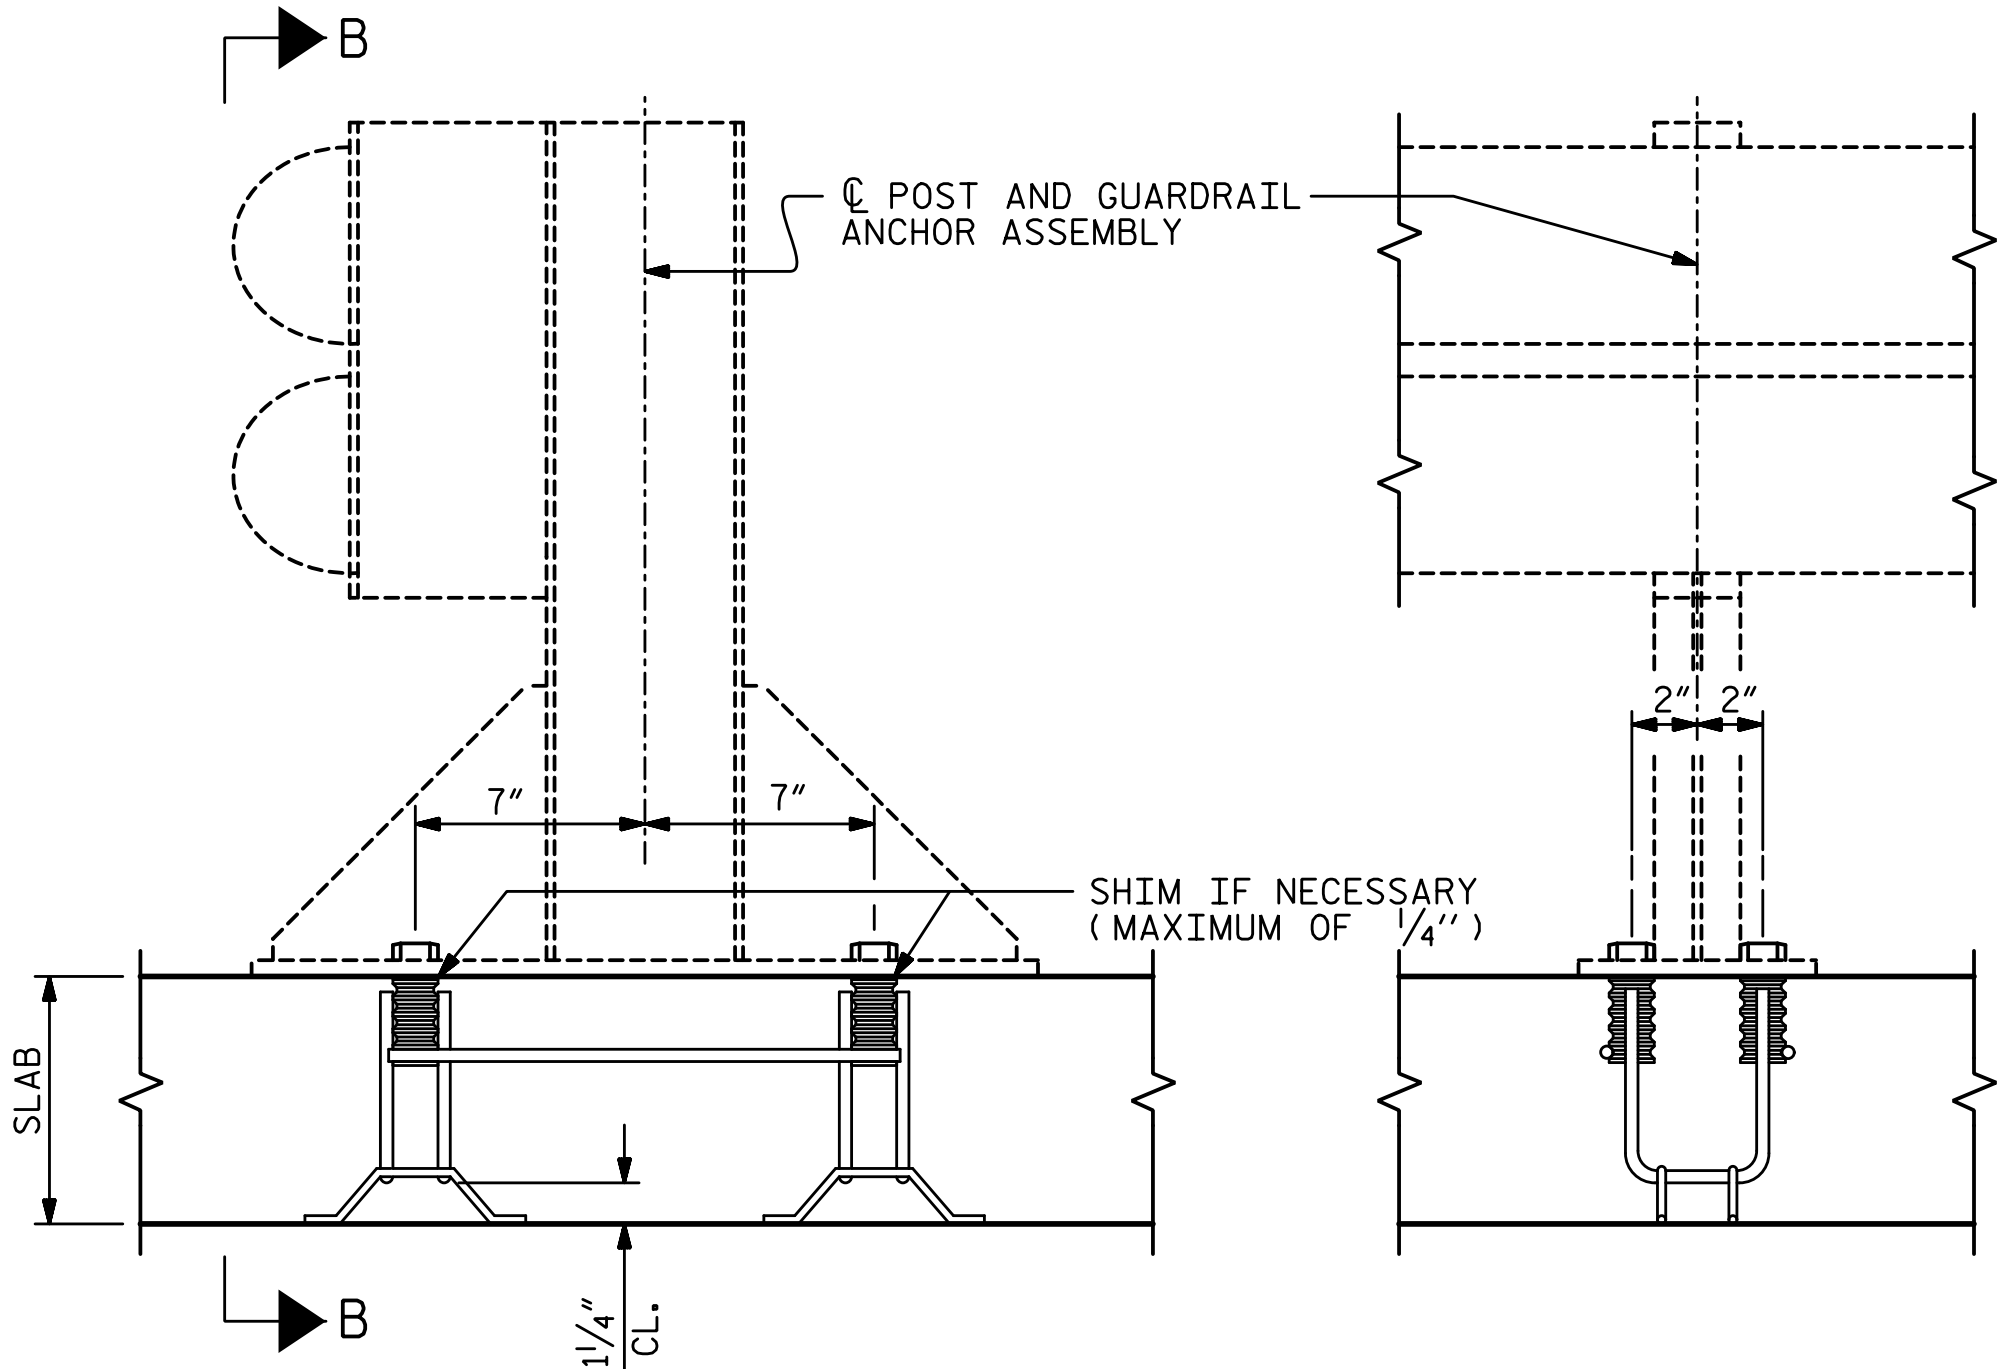


SECTION A-A

SECTION B-B

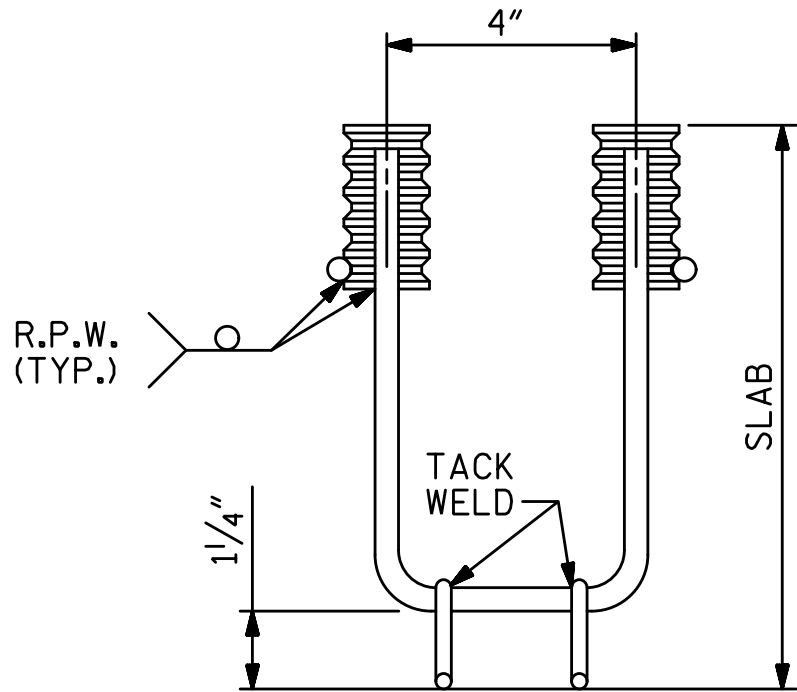


ELEVATION

THIS SUPPORT SHALL MEET THE REQUIREMENTS AS SPECIFIED FOR SUPPORTS FOR REINFORCING STEEL. SEE SPECIFICATIONS.

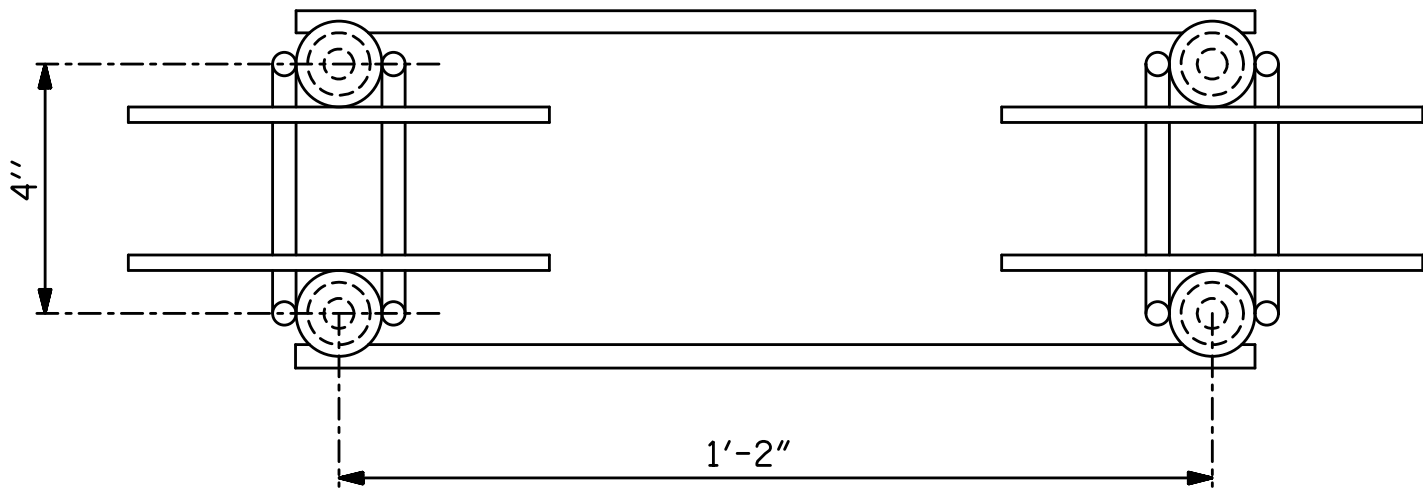

PLAN

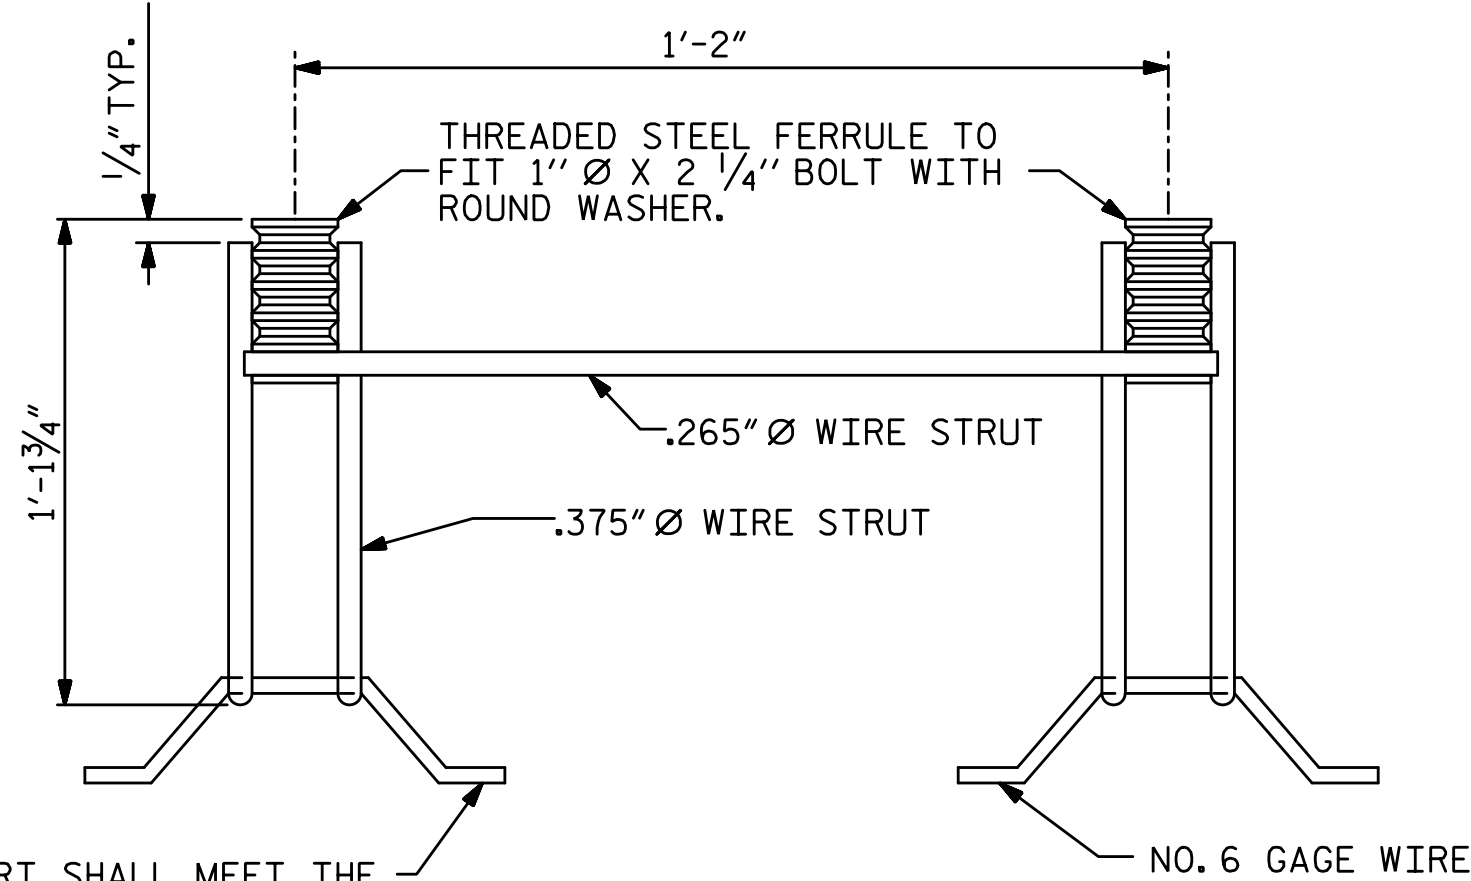

SIDE VIEW

GUARDRAIL ANCHOR ASSEMBLY FOR CULVERTS

NOTES:

THE GUARDRAIL ANCHOR ASSEMBLY FOR CULVERTS SHALL CONSIST OF THE FOLLOWING COMPONENTS :

- FERRULES SHALL BE MADE FROM STEEL MEETING THE REQUIREMENTS OF AASHTO M169, GRADE 12L14 AND SHALL HAVE A MINIMUM LENGTH OF THREADS OF 2 1/2".
- 4 - 1" Ø X 2 1/4" BOLTS WITH WASHERS, BOLTS SHALL CONFORM TO THE REQUIREMENTS OF ASTM A307. BOLTS AND WASHERS SHALL BE GALVANIZED. (AT THE CONTRACTOR'S OPTION, STAINLESS STEEL BOLTS AND WASHERS MAY BE USED AS AN ALTERNATE FOR THE 1" Ø X 2 1/4" GALVANIZED BOLTS AND WASHERS. THEY SHALL CONFORM TO OR EXCEED THE MECHANICAL REQUIREMENTS OF ASTM A307. THE USE OF THIS ALTERNATE SHALL BE APPROVED BY THE ENGINEER.)
- WIRE STRUTS SHOWN IN THE GUARDRAIL ANCHOR ASSEMBLY FOR CULVERTS DETAIL ARE MINIMUM ALLOWABLE SIZE AND SHALL HAVE A MINIMUM TENSILE STRENGTH OF 100,000 P.S.I. AS AN OPTION, A 1/16" Ø WIRE STRUT WITH A MINIMUM TENSILE STRENGTH OF 90,000 PSI IS ACCEPTABLE.

GUARDRAIL ANCHOR ASSEMBLY WITH BOLTS SHALL BE ASSEMBLED IN THE SHOP. BOLT THREADS MAY BE RECUT AS NECESSARY TO INSURE FIT.

THE COST OF THE GUARDRAIL ANCHOR ASSEMBLY FOR CULVERTS COMPLETE IN PLACE, SHALL BE INCLUDED IN THE UNIT CONTRACT PRICE BID FOR CLASS "A" CONCRETE.

FERRULES TO BE PLUGGED DURING POURING OF SLAB AS RECOMMENDED BY THE MANUFACTURER.

AT THE CONTRACTOR'S OPTION, FERRULES WITH OPEN OR CLOSED ENDS MAY BE USED.

PAYMENT FOR GUARDRAIL, POSTS, AND POST BASE PLATES IS INCLUDED IN ROADWAY PAY ITEMS.

SLAB REINFORCING STEEL MAY BE SHIFTED AS NECESSARY TO CLEAR GUARDRAIL ANCHOR ASSEMBLY. CARE SHOULD BE TAKEN TO KEEP THE SHIFTING OF REINFORCING STEEL TO A MINIMUM.

THE CONTRACTOR MAY USE ADHESIVELY ANCHORED ANCHOR BOLTS IN PLACE OF GUARDRAIL ANCHOR ASSEMBLY. LEVEL TWO FIELD TESTING IS REQUIRED, AND THE YIELD LOAD OF THE 1" Ø BOLT IS 21.8 KIPS. FOR ADHESIVELY ANCHORED ANCHOR BOLTS OR DOWELS, SEE STANDARD SPECIFICATIONS.

PROJECT NO. 17BP.7.R.99
ORANGE COUNTY
STATION: 13+86.00 -L-

SHEET 5 OF 6


STATE OF NORTH CAROLINA
DEPARTMENT OF TRANSPORTATION
RALEIGH

ANCHORAGE DETAILS
FOR GUARDRAIL
ANCHOR ASSEMBLY
FOR CULVERTS

REVISIONS

NO.	BY:	DATE:	NO.	BY:	DATE:	SHEET NO.
1			3			C-5
2			4			TOTAL SHEETS 6


PLANS PREPARED BY:
SE & A
IMPSON ENGINEERS ASSOCIATES
5640 Dillard Drive
Suite 200
Cary, NC 27518
(919) 852-0468
(919) 852-0598 (Fax)
www.slmpsonengr.com
LICENSURE NO. C-2521

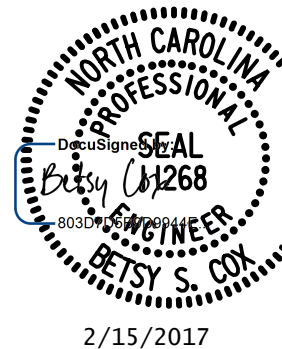

DOCUMENT NOT CONSIDERED FINAL
UNLESS ALL SIGNATURES COMPLETED

2/15/2017 9:39:14 AM G:\Projects\2015\Division 7 (Hatch Mot+T)\17BP7R99 (Orange 209) (012X7 Culvert)\Structures\Drawings\Final\410_17BP7R99_SMU_CU.dgn

LOAD AND RESISTANCE FACTOR RATING (LRFR) SUMMARY FOR REINFORCED CONCRETE BOX CULVERTS															
LEVEL	VEHICLE	WEIGHT (W) (TONS)	<div>⬡</div>	MINIMUM RATING FACTORS (RF)	TONS = W × RF	STRENGTH I LIMIT STATE									COMMENT NUMBER
						LIVE-LOAD FACTORS (γ _{LL})	MOMENT				SHEAR				
							RATING FACTOR	BOX NO.	ELEMENT TYPE	DISTANCE FROM LEFT END OF ELEMENT (ft)	RATING FACTOR	BOX NO.	ELEMENT TYPE	DISTANCE FROM LEFT END OF ELEMENT (ft)	
DESIGN LOAD RATING	HL-93 (INVENTORY)	N/A	<div>⬡1</div>	1.29	- -	1.75	1.29	1	TOP SLAB -MID	5.07	1.49	1	BOT SLAB - RT END	11.61	
	HL-93 (OPERATING)	N/A		1.67	- -	1.35	1.67	1	TOP SLAB -MID	5.07	1.93	1	BOT SLAB - RT END	11.61	
	HS-20 (INVENTORY)	36.000	<div>⬡2</div>	1.55	55.8	1.75	1.55	1	TOP SLAB -MID	5.07	1.70	1	TOP SLAB - RT END	11.4	
	HS-20 (OPERATING)	36.000		2.01	72.3	1.35	2.01	1	TOP SLAB -MID	5.07	2.20	1	TOP SLAB - RT END	11.4	
LEGAL LOAD RATING	SINGLE VEHICLE (SV)	SNSH		2.19	29.6	1.40	2.19	1	TOP SLAB -MID	5.07	2.80	1	TOP SLAB - RT END	11.4	
		SNGARBS2		2.04	40.8	1.40	2.04	1	TOP SLAB -MID	5.07	2.59	1	TOP SLAB - RT END	11.4	
		SNAGRIS2		2.18	48.0	1.40	2.18	1	TOP SLAB -MID	5.07	2.38	1	BOT SLAB - RT END	11.61	
		SNCOTTS3		1.38	37.6	1.40	1.38	1	TOP SLAB -MID	5.07	1.46	1	TOP SLAB - RT END	11.4	
		SNAGGRS4		1.51	52.7	1.40	1.62	1	TOP SLAB -MID	5.07	1.51	1	TOP SLAB - RT END	11.4	
		SNS5A		1.48	52.6	1.40	1.55	1	TOP SLAB -MID	5.07	1.48	1	TOP SLAB - RT END	11.4	
		SNS6A		1.45	57.9	1.40	1.55	1	TOP SLAB -MID	5.07	1.45	1	TOP SLAB - RT END	11.4	
		SNS7B		1.46	61.3	1.40	1.62	1	TOP SLAB -MID	5.07	1.46	1	TOP SLAB - RT END	11.4	
	TRUCK TRACTOR SEMI-TRAILER (TTST)	TNAGRIT3		1.60	52.8	1.40	2.13	1	BOT SLAB -MID	5.07	1.60	1	TOP SLAB - RT END	11.4	
		TNT4A		1.64	54.2	1.40	1.64	1	TOP SLAB -MID	5.07	1.64	1	TOP SLAB - RT END	11.4	
		TNT6A		1.55	64.5	1.40	1.67	1	TOP SLAB -MID	5.07	1.55	1	TOP SLAB - RT END	11.4	
		TNT7A		1.39	58.4	1.40	1.65	1	TOP SLAB -MID	5.07	1.39	1	TOP SLAB - RT END	11.4	
		TNT7B		1.48	62.2	1.40	1.55	1	TOP SLAB -MID	5.07	1.48	1	TOP SLAB - RT END	11.4	
		TNAGRIT4	<div>⬡3</div>	1.26	54.2	1.40	1.64	1	TOP SLAB -MID	5.07	1.26	1	TOP SLAB - RT END	11.4	
		TNAGT5A		1.39	62.6	1.40	1.83	1	TOP SLAB -MID	5.07	1.39	1	TOP SLAB - RT END	11.4	
		TNAGT5B		1.32	59.4	1.40	1.64	1	TOP SLAB -MID	5.07	1.32	1	TOP SLAB - RT END	11.4	

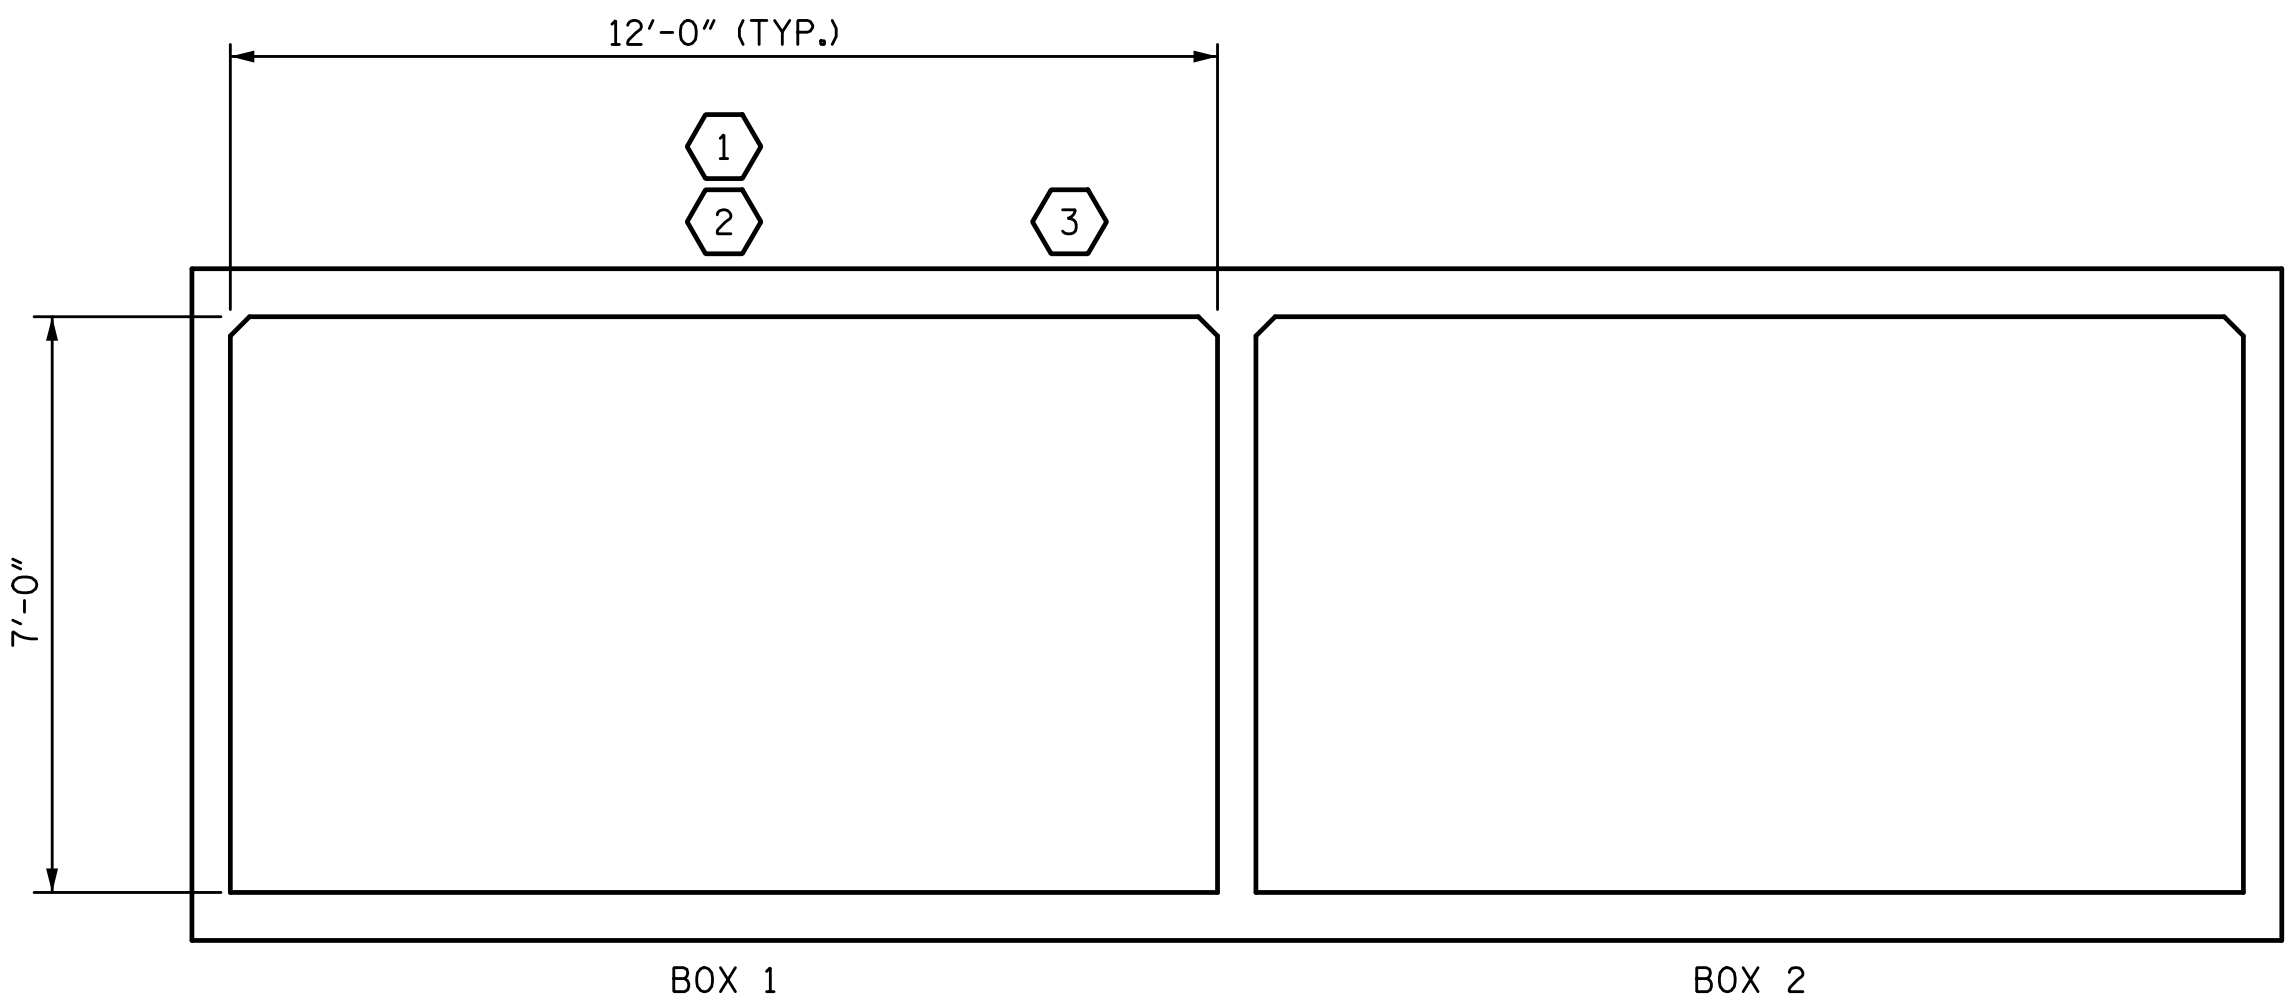


LRFR SUMMARY
(LOOKING DOWNSTREAM)

DRAWN BY: <u>T. BANKOVICH</u>	DATE: <u>7-16</u>
CHECKED BY: <u>B.S. COX</u>	DATE: <u>7-16</u>
DESIGN ENGINEER OF RECORD: <u>B.S. COX</u>	DATE: <u>7-16</u>

PLANS PREPARED BY:

SIMPSON
& ASSOCIATES
5640 Dillard Drive
Suite 200
Cary, NC 27518
(919) 852-0468
(919) 852-0598 (Fax)
www.simpsonengr.com
[LICENSURE NO. C-2521]

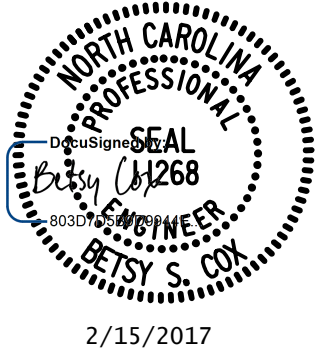

PROJECT NO. 17BP.7.R.99
ORANGE COUNTY
STATION: 13+86.00 -L-

SHEET 6 OF 6

STATE OF NORTH CAROLINA DEPARTMENT OF TRANSPORTATION RALEIGH						SHEET NO. C-6	
LRFR SUMMARY FOR REINFORCED CONCRETE BOX CULVERTS (NON-INTERSTATE TRAFFIC)						TOTAL SHEETS 6	
REVISIONS							
NO.	BY:	DATE:	NO.	BY:	DATE:		
1			3				
2			4				

DOCUMENT NOT CONSIDERED FINAL
UNLESS ALL SIGNATURES COMPLETED

LOAD FACTORS:

DESIGN LOAD RATING FACTORS

LOAD TYPE	MAX FACTOR	MIN FACTOR
DC	1.25	0.90
DW	1.50	0.65
EV	1.30	0.90
EH	1.35	0.90
ES	1.35	0.90
LS	1.75	--
WA	1.00	--

NOTE:

RATING FACTORS ARE BASED ON THE STRENGTH I LIMIT STATE.

⬡ CONTROLLING LOAD RATING
⬡1 DESIGN LOAD RATING (HL-93)
⬡2 DESIGN LOAD RATING (HS-20)
⬡3 LEGAL LOAD RATING **
** SEE CHART FOR VEHICLE TYPE

2/15/2017 9:39:14 AM G:\Projects\2015\Division 7 (Hatch Mot-t)\17BP7R99 (Orange 209) (D12XT7 Culvert)\Structures\Drawings\Final\410_17BP7R99_SMU_SN.dgn

DESIGN DATA:

SPECIFICATIONS	- - - - -	A.A.S.H.T.O. (CURRENT)
LIVE LOAD	- - - - -	SEE PLANS
IMPACT ALLOWANCE	- - - - -	SEE A.A.S.H.T.O.
STRESS IN EXTREME FIBER OF		
STRUCTURAL STEEL - AASHTO M270 GRADE 36	-	20,000 LBS. PER SQ. IN.
- AASHTO M270 GRADE 50W	-	27,000 LBS. PER SQ. IN.
- AASHTO M270 GRADE 50	-	27,000 LBS. PER SQ. IN.
REINFORCING STEEL IN TENSION		
GRADE 60	- -	24,000 LBS. PER SQ. IN.
CONCRETE IN COMPRESSION	- - - - -	1,200 LBS. PER SQ. IN.
CONCRETE IN SHEAR	- - - - -	SEE A.A.S.H.T.O.
STRUCTURAL TIMBER - TREATED OR		
UNTREATED - EXTREME FIBER STRESS	- - - - -	1,800 LBS. PER SQ. IN.
COMPRESSION PERPENDICULAR TO GRAIN OF TIMBER	- - - -	375 LBS. PER SQ. IN.
EQUIVALENT FLUID PRESSURE OF EARTH	- - - - -	30 LBS. PER CU. FT.
		(MINIMUM)

MATERIAL AND WORKMANSHIP:

EXCEPT AS MAY OTHERWISE BE SPECIFIED ON PLANS OR IN THE SPECIAL PROVISIONS, ALL MATERIAL AND WORKMANSHIP SHALL BE IN ACCORDANCE WITH THE 2012 "STANDARD SPECIFICATIONS FOR ROADS AND STRUCTURES" OF THE N. C. DEPARTMENT OF TRANSPORTATION.

STEEL SHEET PILING FOR PERMANENT OR TEMPORARY APPLICATIONS SHALL BE HOT ROLLED.

CONCRETE:

UNLESS OTHERWISE REQUIRED ON PLANS, CLASS A CONCRETE SHALL BE USED FOR ALL PORTIONS OF ALL STRUCTURES WITH THE EXCEPTION THAT: CLASS AA CONCRETE SHALL BE USED IN BRIDGE SUPERSTRUCTURES, ABUTMENT BACKWALLS, AND APPROACH SLABS; AND CLASS B CONCRETE SHALL BE USED FOR SLOPE PROTECTION AND RIP RAP.

CONCRETE CHAMFERS:

UNLESS OTHERWISE NOTED ON THE PLANS, ALL EXPOSED CORNERS ON STRUCTURES SHALL BE CHAMFERED 3/4" WITH THE FOLLOWING EXCEPTIONS: TOP CORNERS OF CURBS MAY BE ROUNDED TO 1-1/2" RADIUS WHICH IS BUILT INTO CURB FORMS; CORNERS OF TRANSVERSE FLOOR EXPANSION JOINTS SHALL BE ROUNDED WITH A 1/4" FINISHING TOOL UNLESS OTHERWISE REQUIRED ON PLANS; AND CORNERS OF EXPANSION JOINTS IN THE ROADWAY FACES AND TOPS OF CURBS AND SIDEWALKS SHALL BE ROUNDED TO A 1/4" RADIUS WITH A FINISHING STONE OR TOOL UNLESS OTHERWISE REQUIRED ON PLANS.

DOWELS:

DOWELS WHEN INDICATED ON PLANS AS FOR CULVERT EXTENSIONS, SHALL BE EMBEDDED AT LEAST 12" INTO THE OLD CONCRETE AND GROUTED INTO PLACE WITH 1:2 CEMENT MORTAR.

STANDARD NOTES

ALLOWANCE FOR DEAD LOAD DEFLECTION, SETTLEMENT:
ETC. IN CASTING SUPERSTRUCTURES:

BRIDGES SHALL BE BUILT ON THE GRADE OR VERTICAL CURVE SHOWN ON PLANS. SLABS, CURBS AND PARAPETS SHALL CONFORM TO THE GRADE OR CURVE.
ALL DIMENSIONS WHICH ARE GIVEN IN SECTION AND ARE AFFECTED BY DEAD LOAD DEFLECTIONS ARE DIMENSIONS AT CENTER LINE OF BEARING UNLESS OTHERWISE NOTED ON PLANS. IN SETTING FORMS FOR STEEL BEAM BRIDGES AND PRESTRESSED CONCRETE GIRDER BRIDGES, ADJUSTMENTS SHALL BE MADE DUE TO THE DEAD LOAD DEFLECTIONS FOR THE ELEVATIONS SHOWN. WHERE BLOCKS ARE SHOWN OVER BEAMS FOR BUILDING UP TO THE SLAB, THE VERTICAL DIMENSIONS OF THE BLOCKS SHALL BE ADJUSTED BETWEEN BEARINGS TO COMPENSATE FOR DEAD LOAD DEFLECTIONS, VERTICAL CURVE ORDINATE, AND ACTUAL BEAM CAMBER. WHERE BOTTOM OF SLAB IS IN LINE WITH BOTTOM OF TOP FLANGES, DEPTH OF SLAB BETWEEN BEARINGS SHALL BE ADJUSTED TO COMPENSATE FOR DEAD LOAD DEFLECTION, VERTICAL CURVE ORDINATE, AND ACTUAL BEAM CAMBER.
IN SETTING FALSEWORK AND FORMS FOR REINFORCED CONCRETE SPANS, AN ALLOWANCE SHALL BE MADE FOR DEAD LOAD DEFLECTIONS, SETTLEMENT OF FALSEWORK, AND PERMANENT CAMBER WHICH SHALL BE PROVIDED FOR IN ADDITION TO THE ELEVATIONS SHOWN. AFTER REMOVAL OF THE FALSEWORK, THE FINISHED STRUCTURES SHALL CONFORM TO THE PROFILE AND ELEVATIONS SHOWN ON THE PLANS AND CONSTRUCTION ELEVATIONS FURNISHED BY THE ENGINEER.
DETAILED DRAWINGS FOR FALSEWORK OR FORMS FOR BRIDGE SUPERSTRUCTURE AND ANY STRUCTURE OR PARTS OF A STRUCTURE AS NOTED ON THE PLANS SHALL BE SUBMITTED TO THE ENGINEER FOR APPROVAL BEFORE CONSTRUCTION OF THE FALSEWORK OR FORMS IS STARTED.

REINFORCING STEEL:

ALL REINFORCING STEEL SHALL BE DEFORMED. DIMENSIONS RELATIVE TO PLACEMENT OF REINFORCING ARE TO CENTERS OF BARS UNLESS OTHERWISE INDICATED IN THE PLANS. DIMENSIONS ON BAR DETAILS ARE TO CENTERS OF BARS OR ARE OUT TO OUT AS INDICATED ON PLANS.
WIRE BAR SUPPORTS SHALL BE PROVIDED FOR REINFORCING STEEL WHERE INDICATED ON THE PLANS. WHEN BAR SUPPORT PIECES ARE PLACED IN CONTINUOUS LINES, THEY SHALL BE SO PLACED THAT THE ENDS OF THE SUPPORTING WIRES SHALL BE LAPPED TO LOCK LEGS ON ADJOINING PIECES.

STRUCTURAL STEEL:

AT THE CONTRACTOR'S OPTION, HE MAY SUBSTITUTE 7/8" Ø SHEAR STUDS FOR THE 3/4" Ø STUDS SPECIFIED ON THE PLANS. THIS SUBSTITUTION SHALL BE MADE AT THE RATE OF 3 - 7/8" Ø STUDS FOR 4 - 3/4" Ø STUDS, AND STUD SPACING CHANGES SHALL BE MADE AS NECESSARY TO PROVIDE THE SAME EQUIVALENT NUMBER OF 7/8" Ø STUDS ALONG THE BEAM AS SHOWN FOR 3/4" Ø STUDS BASED ON THE RATIO OF 3 - 7/8" Ø STUDS FOR 4 - 3/4" Ø STUDS. STUDS OF THE LENGTH SPECIFIED ON THE PLANS MUST BE PROVIDED. THE MAXIMUM SPACING SHALL BE 2'-0".
EXCEPT AT THE INTERIOR SUPPORTS OF CONTINUOUS BEAMS WHERE THE COVER PLATE IS IN CONTACT WITH BEARING PLATE, THE CONTRACTOR MAY, AT HIS OPTION, SUBSTITUTE FOR THE COVER PLATES DESIGNATED ON THE PLANS COVER PLATES OF THE EQUIVALENT AREA PROVIDED THESE PLATES ARE AT LEAST 5/16" IN THICKNESS AND DO NOT EXCEED A WIDTH EQUAL TO THE FLANGE WIDTH LESS 2" OR A THICKNESS EQUAL TO 2 TIMES THE FLANGE THICKNESS. THE SIZE OF FILLET WELDS SHALL CONFORM TO THE REQUIREMENTS OF THE CURRENT ANSI/AASHTO/AWS "BRIDGE WELDING CODE". ELECTROSLAG WELDING WILL NOT BE PERMITTED.
WITH THE SOLE EXCEPTION OF EDGES AT SURFACES WHICH BEAR ON OTHER SURFACES, ALL SHARP EDGES AND ENDS OF SHAPES AND PLATES SHALL BE SLIGHTLY ROUNDED BY SUITABLE MEANS TO A RADIUS OF APPROXIMATELY 1/16 INCH OR EQUIVALENT FLAT SURFACE AT A SUITABLE ANGLE PRIOR TO PAINTING, GALVANIZING, OR METALLIZING.

HANDRAILS AND POSTS:

METAL STANDARDS AND FACES OF THE CONCRETE END POSTS FOR THE METAL RAIL SHALL BE SET NORMAL TO THE GRADE OF THE CURB, UNLESS OTHERWISE SHOWN ON PLANS. THE METAL RAIL AND TOPS OF CONCRETE POSTS USED WITH THE ALUMINUM RAIL SHALL BE BUILT PARALLEL TO THE GRADE OF THE CURB.
METAL HANDRAILS SHALL BE IN ACCORDANCE WITH THE PLANS. RAILS SHALL BE AS MANUFACTURED FOR BRIDGE RAILING. CASTINGS SHALL BE OF A UNIFORM APPEARANCE. FINIS AND OTHER DEFORMATIONS RESULTING FROM CASTING OR OTHERWISE SHALL BE REMOVED IN A MANNER SO THAT A UNIFORM COLORING OF THE COMPLETED CASTING SHALL BE OBTAINED. CASTINGS WITH DISCOLORATIONS OR OF NON-UNIFORM COLORING WILL NOT BE ACCEPTED. CERTIFIED MILL REPORTS ARE REQUIRED FOR METAL RAILS AND POSTS.

SPECIAL NOTES:

GENERALLY, IN CASE OF DISCREPANCY, THIS STANDARD SHEET OF NOTES SHALL GOVERN OVER THE SPECIFICATIONS, BUT THE REMAINDER OF THE PLANS SHALL GOVERN OVER NOTES HEREON, AND SPECIAL PROVISIONS SHALL GOVERN OVER ALL. SEE SPECIFICATIONS ARTICLE 105-4.